

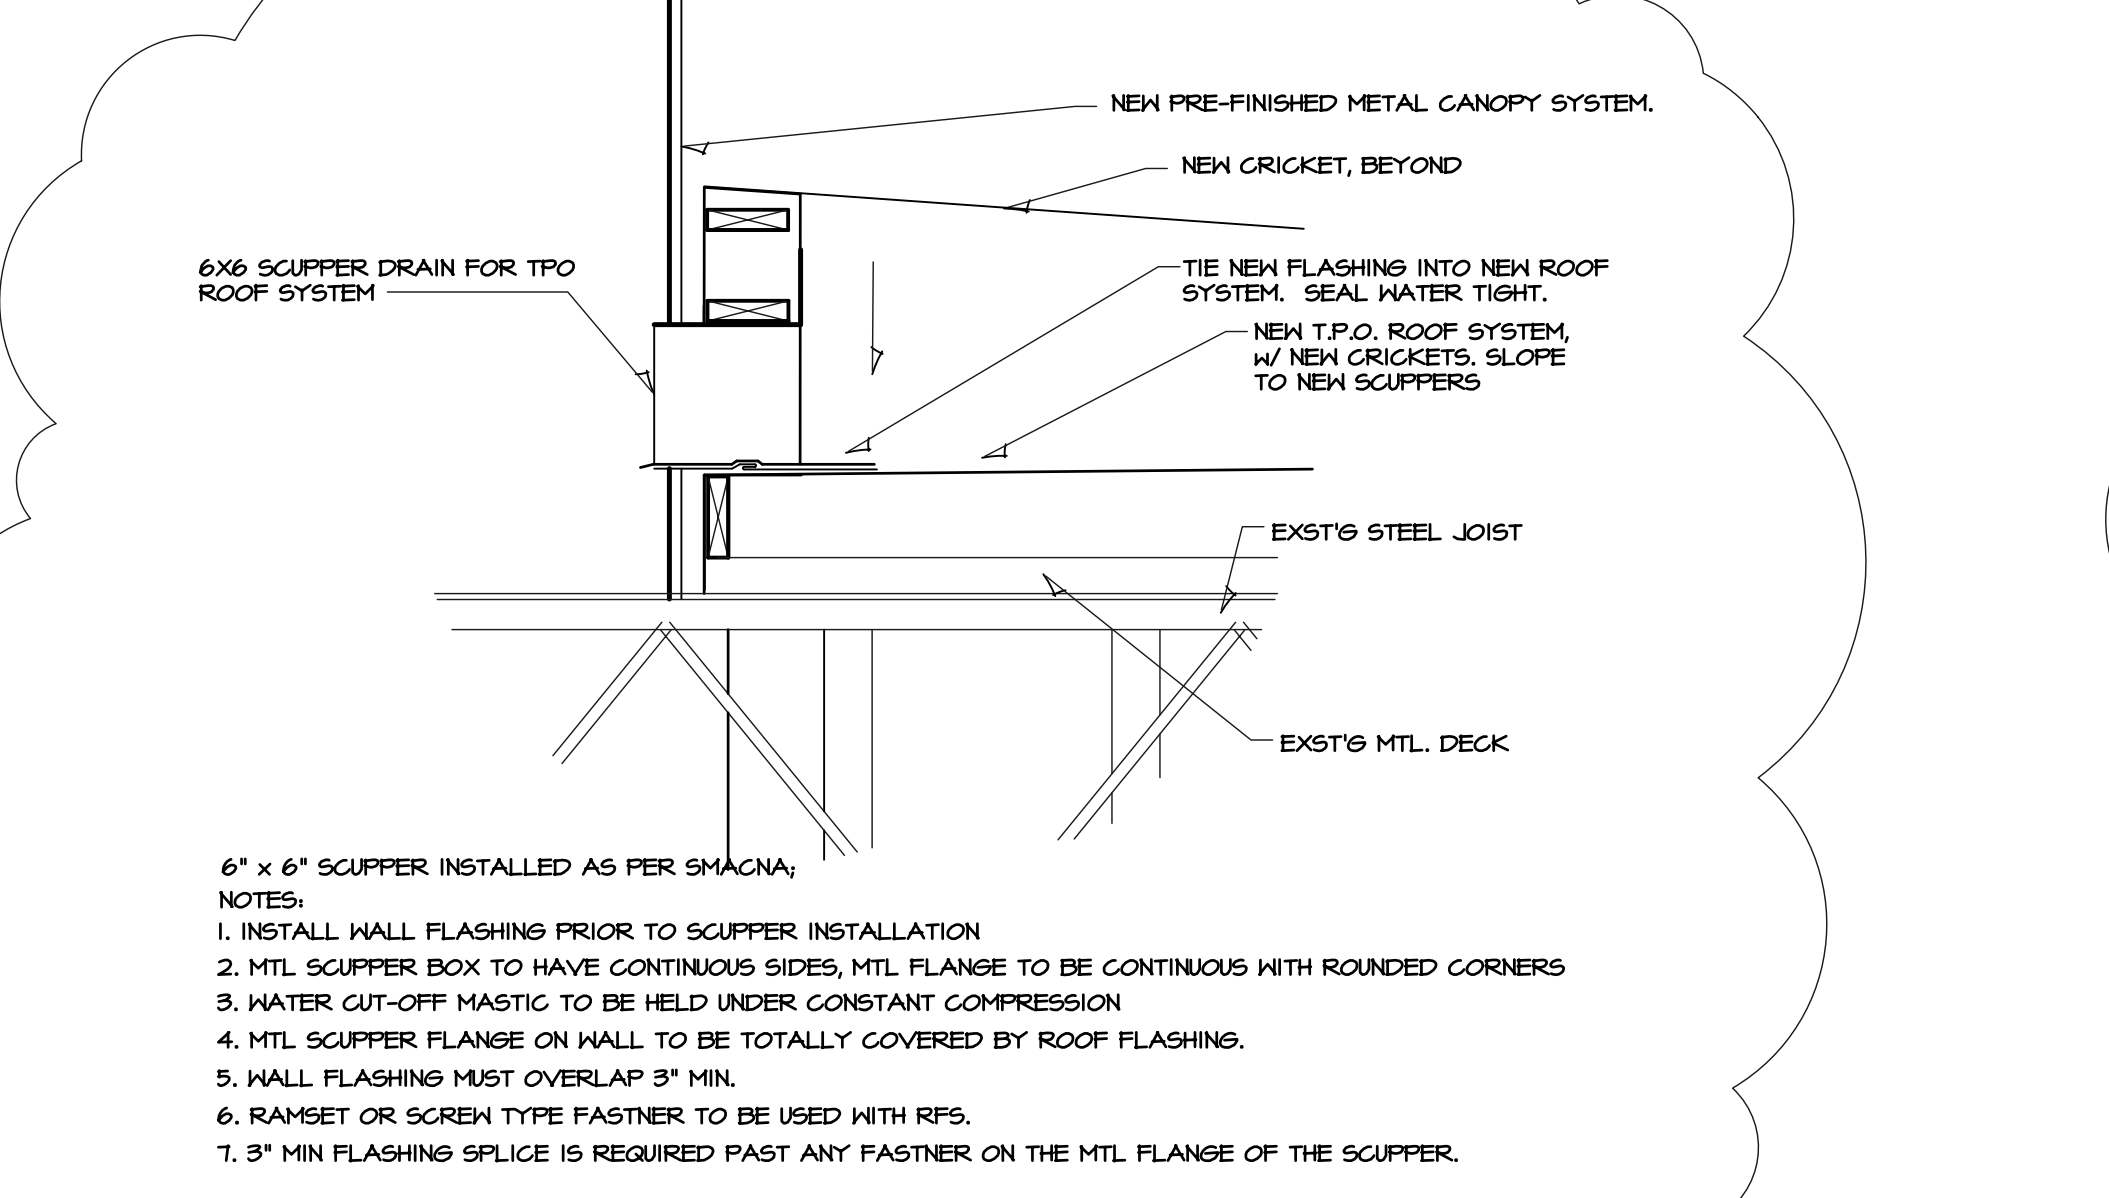
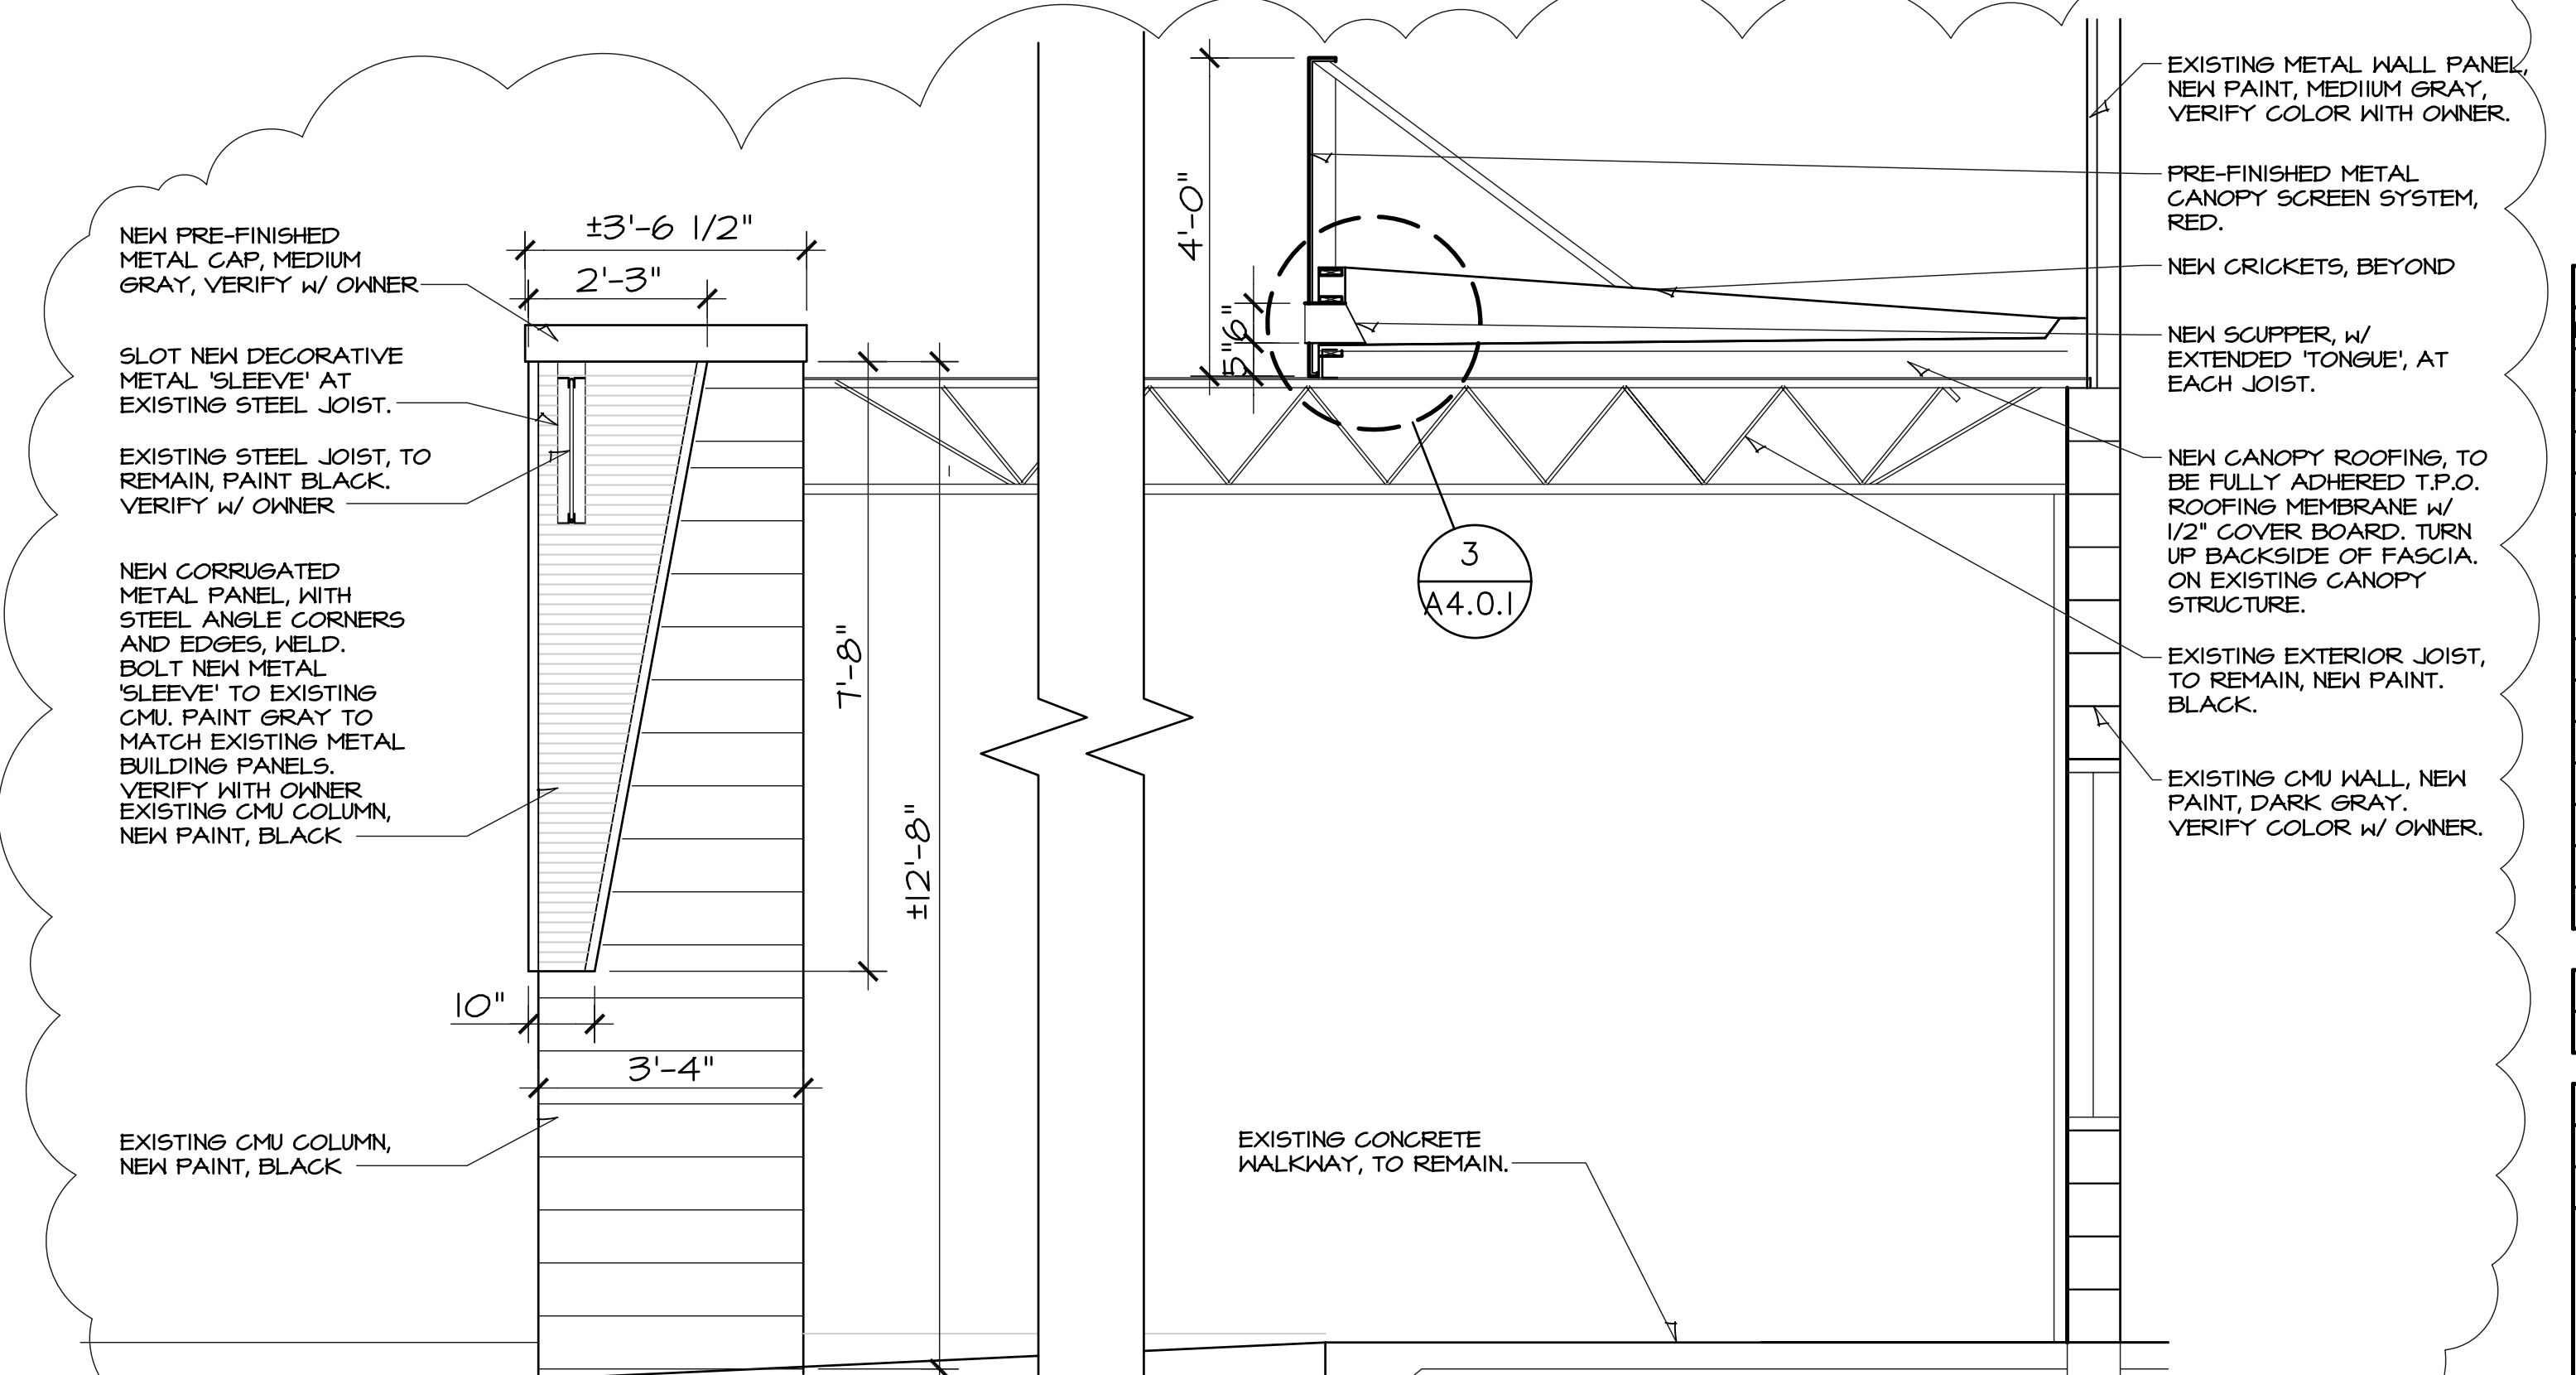



1 WALL SECTION
SCALE: 1" = 1'-0"

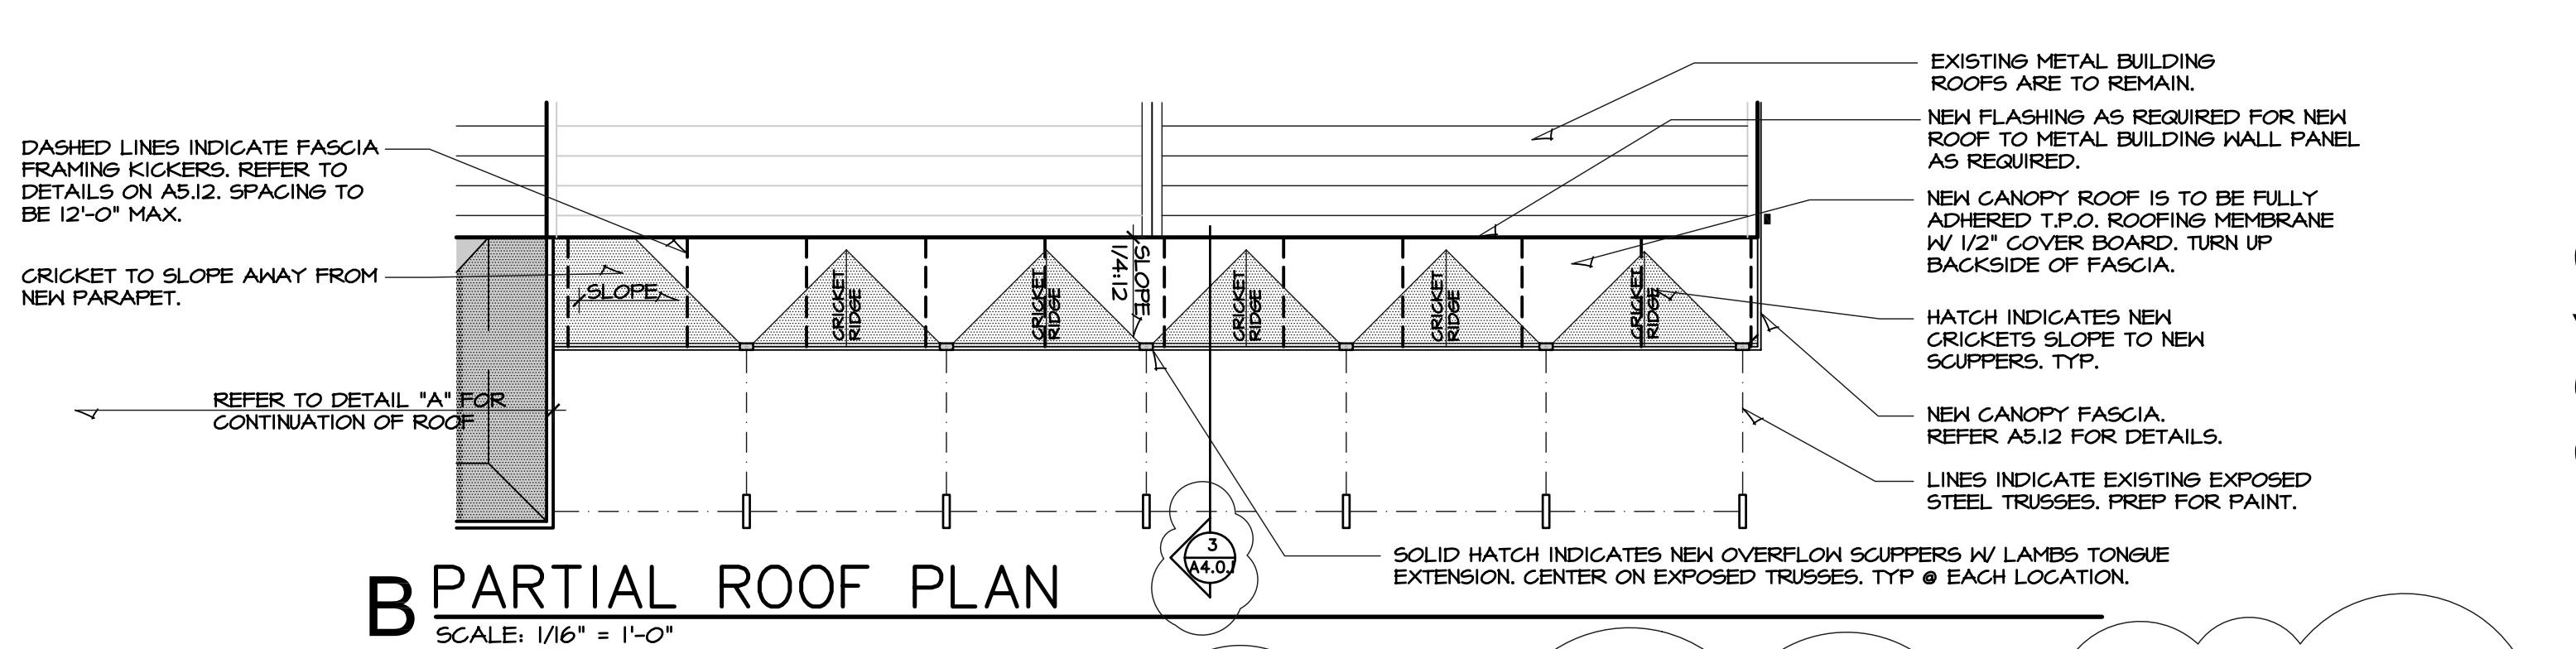

2 SCUPPER DETAIL
SCALE: 1 1/2" = 1'-0"

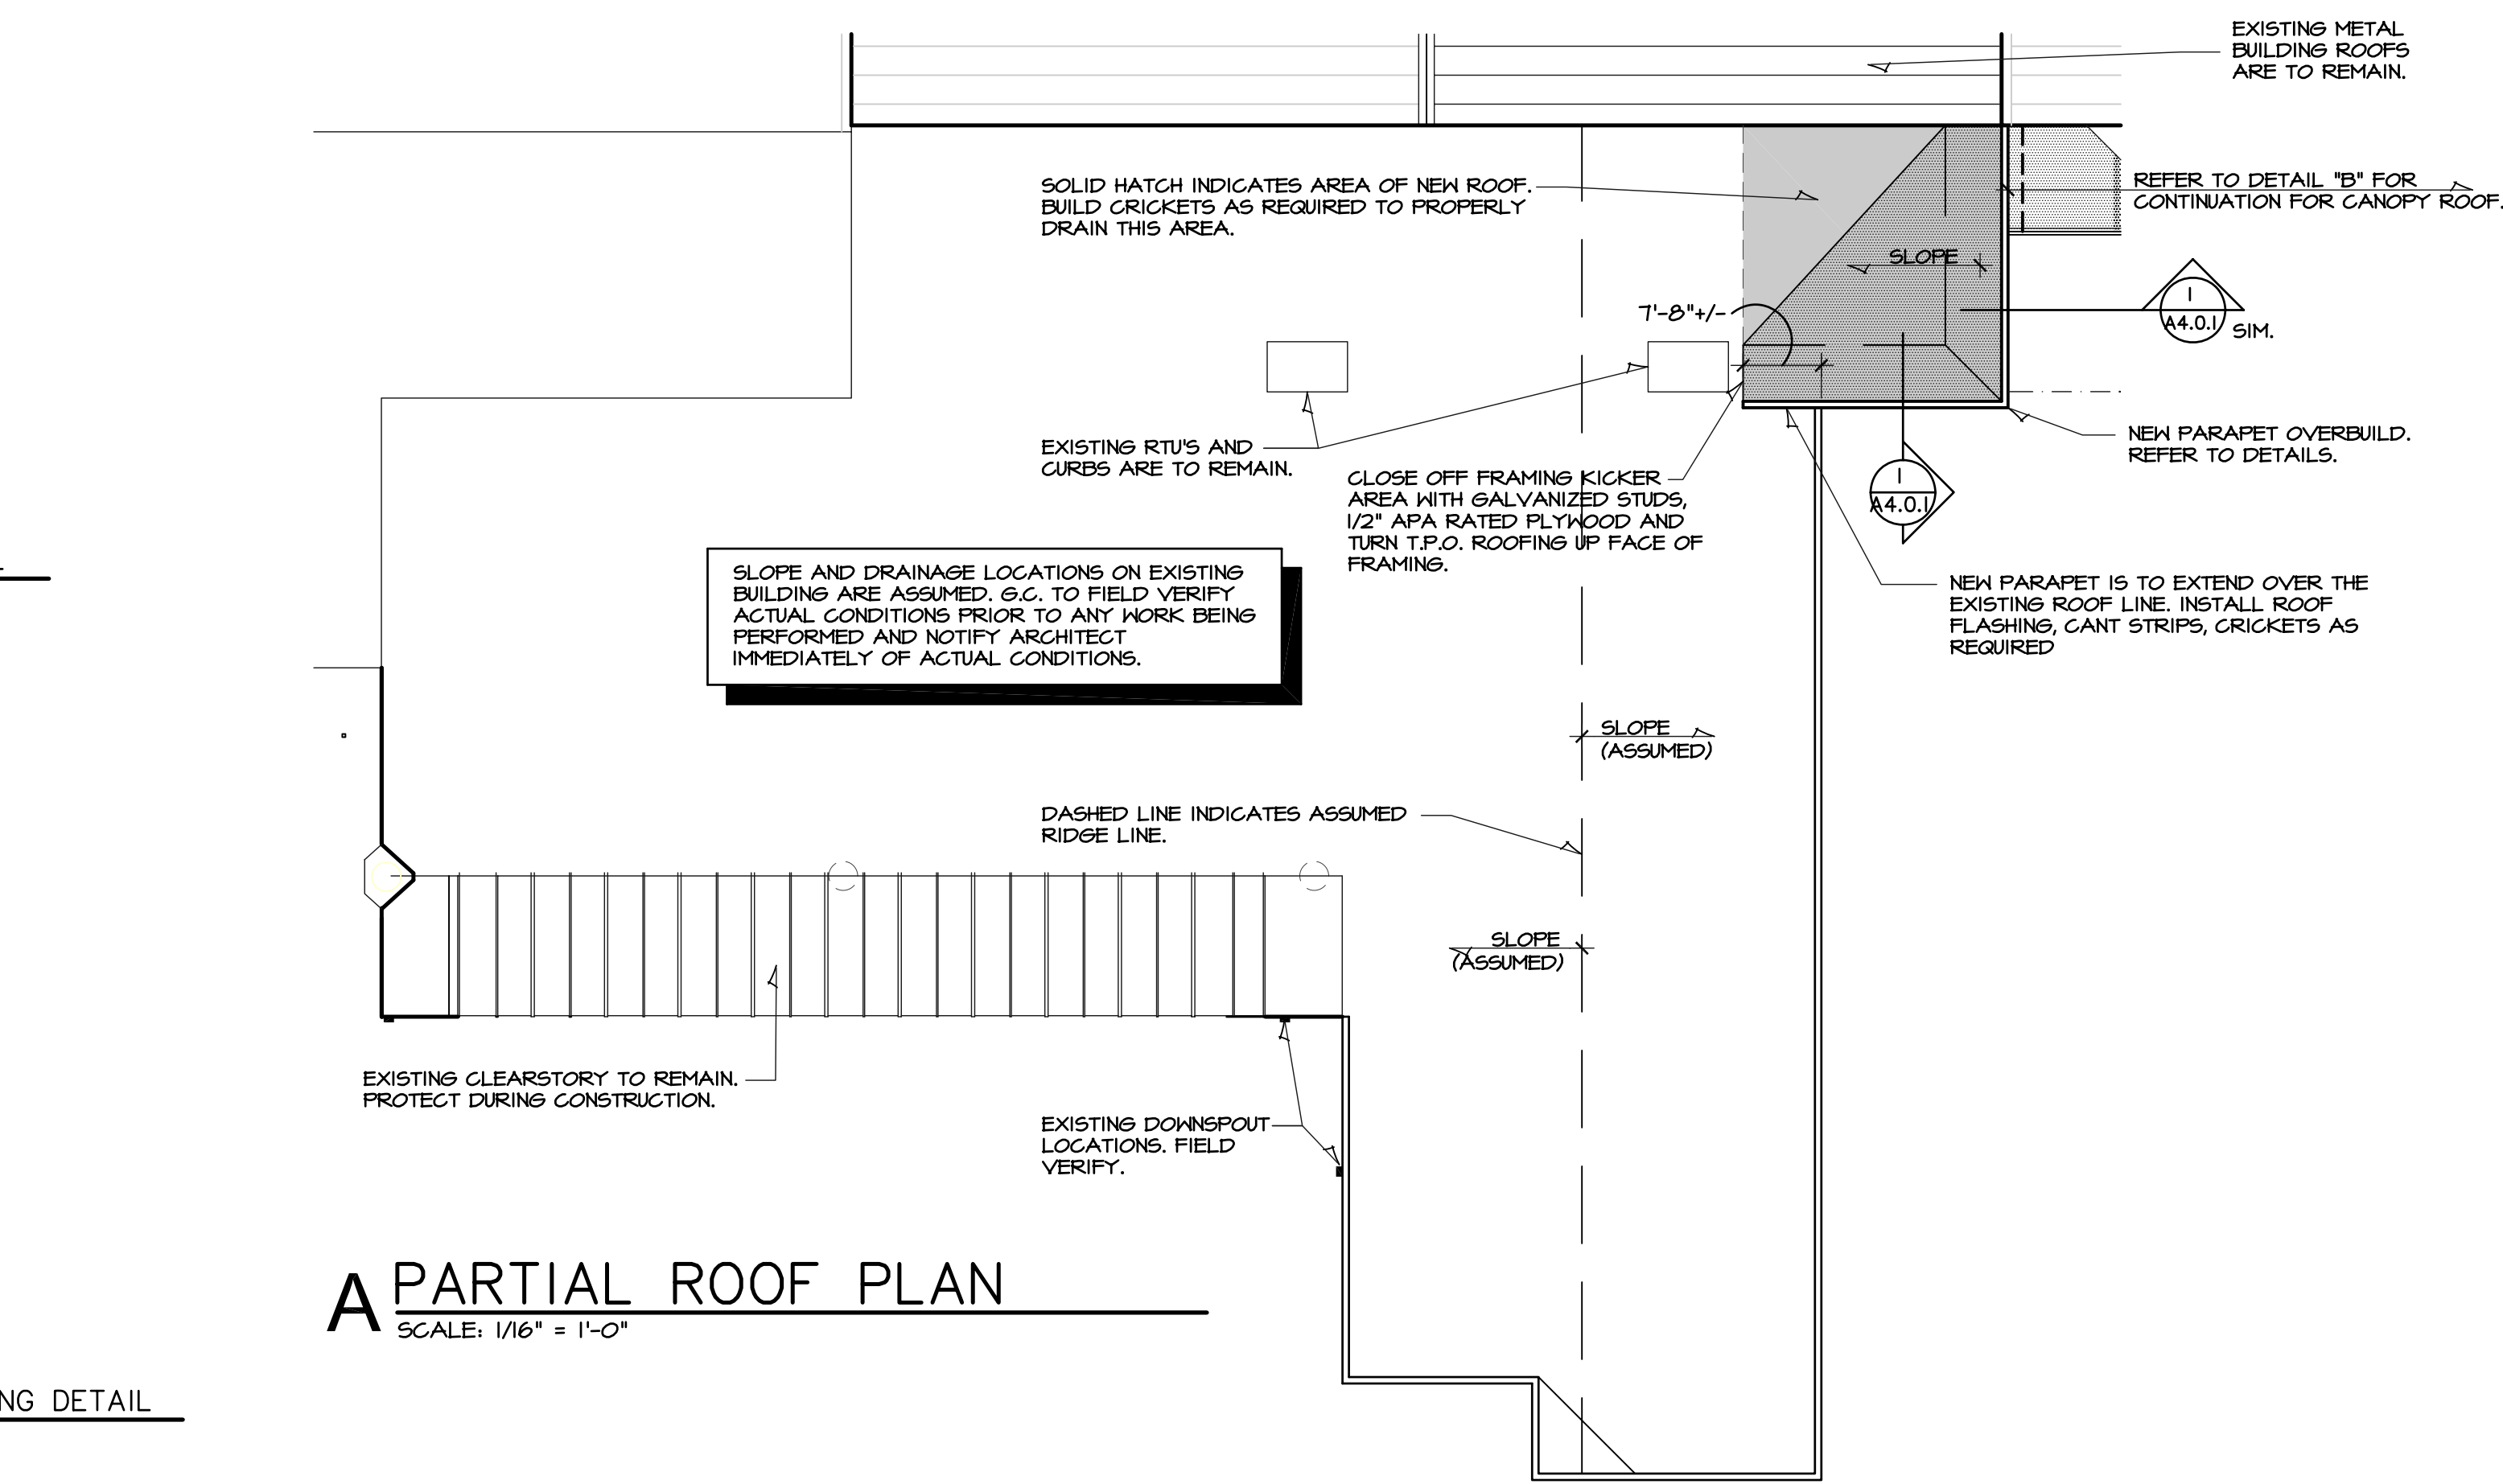

3 CANOPY SECTION
SCALE: 1/2" = 1'-0"

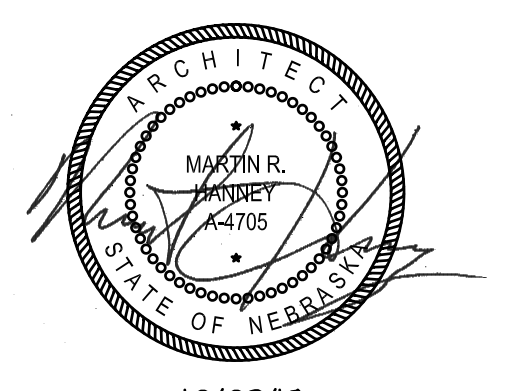

10/02/19
HANNAY & ASSOCIATES, ARCHITECTS
1726 South Hillside, Wichita, Kansas, 67211
Phone: (316) 683-8965
Fax: (316) 684-1441

2019 GENESIS HEALTH CLUBS WESTROADS
1212 NORTH 102ND STREET
OMAHA, NE 68114



DRAWINGS ISSUED			
NO.	DATE	ITEM	ISSUED
20	10/02/19	ADDENDA #2	
19	09/04/19	BID SET	
18	09/03/19	CODE REVIEW	
17	08/26/19	CODE REVIEW	
16	08/11/19	CODE REVISIONS	
15	06/17/19	CODE REVISIONS	
14	04/22/19	PLAN REVIEW	
13	02/18/19	REVIEW	
12	01/29/19	REVIEW	
11	01/08/19	REVISIONS	
10	12/19/18	REVIEW	
9	11/27/18	REVIEW	

COMPUTER DRAWING
GOE_A4.0.1.dwg

DATE: APRIL 2019
DRAWN BY: CHECKED BY:
MH, CH, JC, MB MRH

SHEET
A4.0.1
OF SHEETS