




**1 WALL SECTION**  
SCALE: 1" = 1'-0"

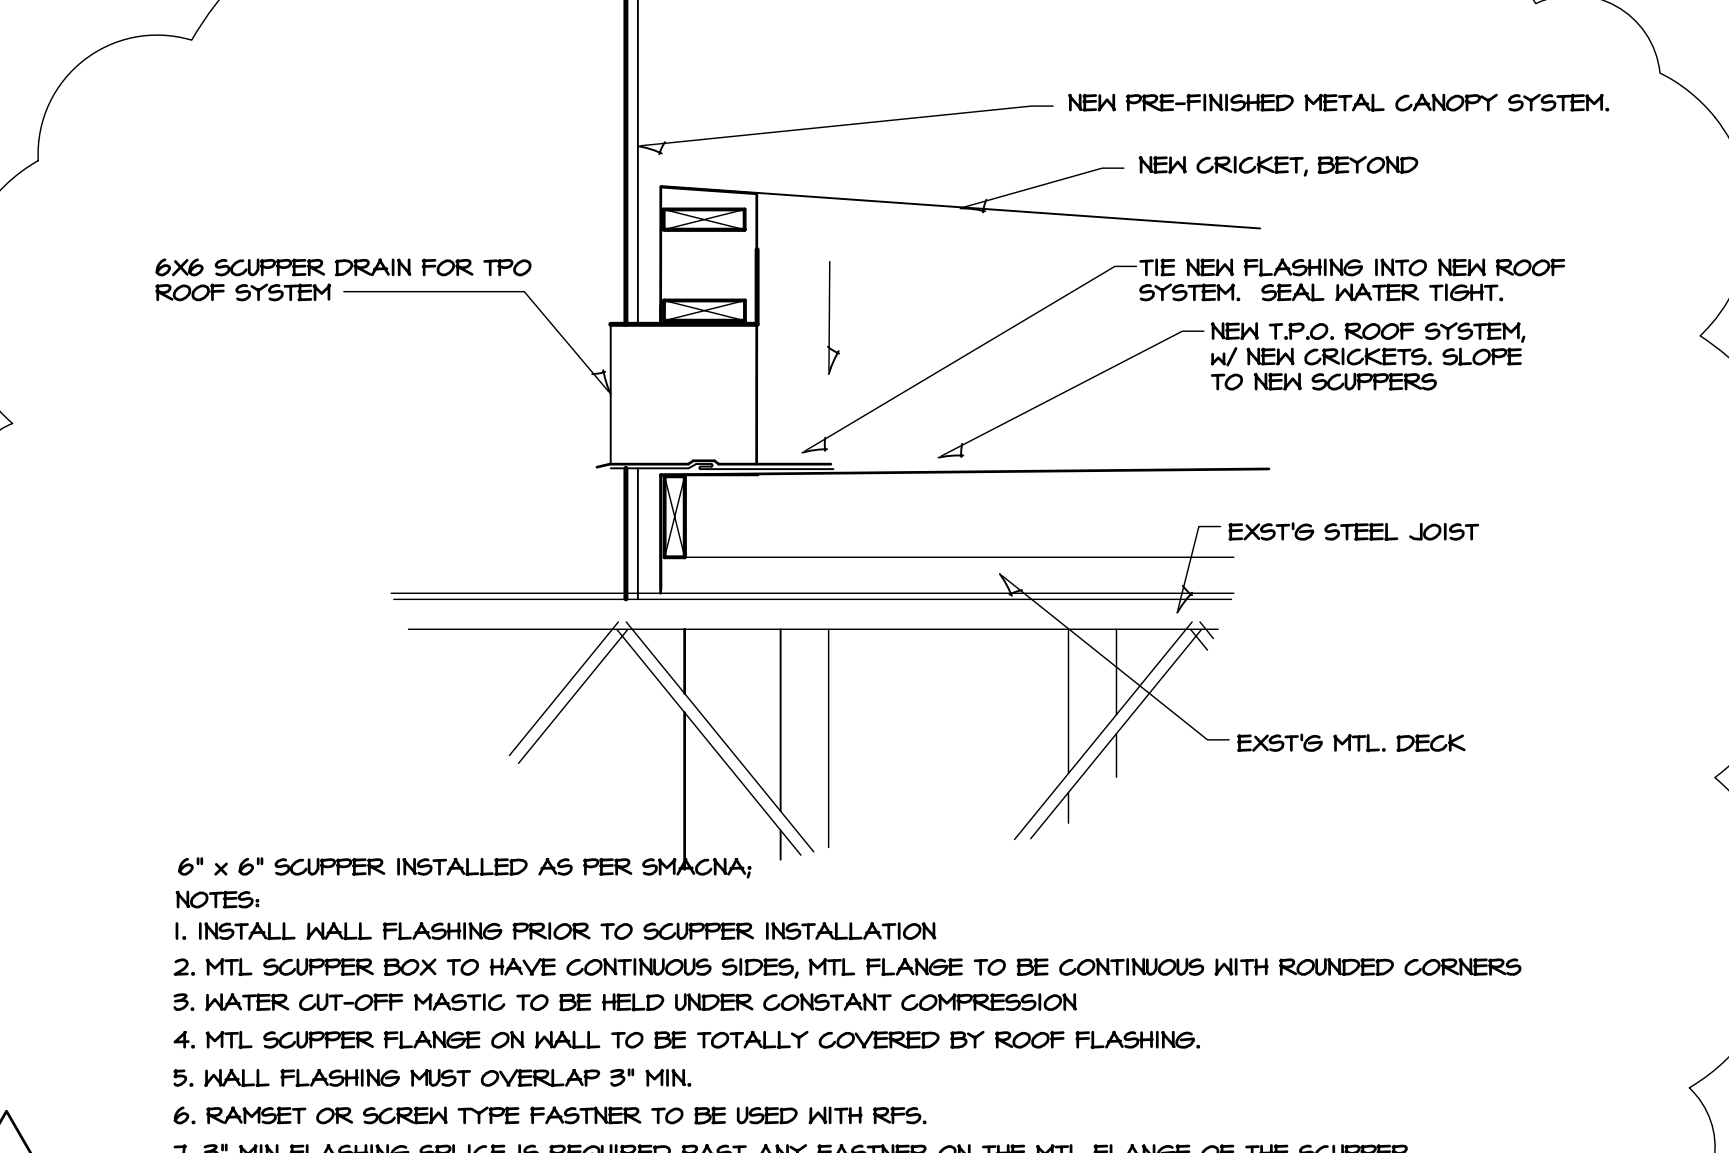


**2 SCUPPER DETAIL**  
SCALE: 1 1/2" = 1'-0"

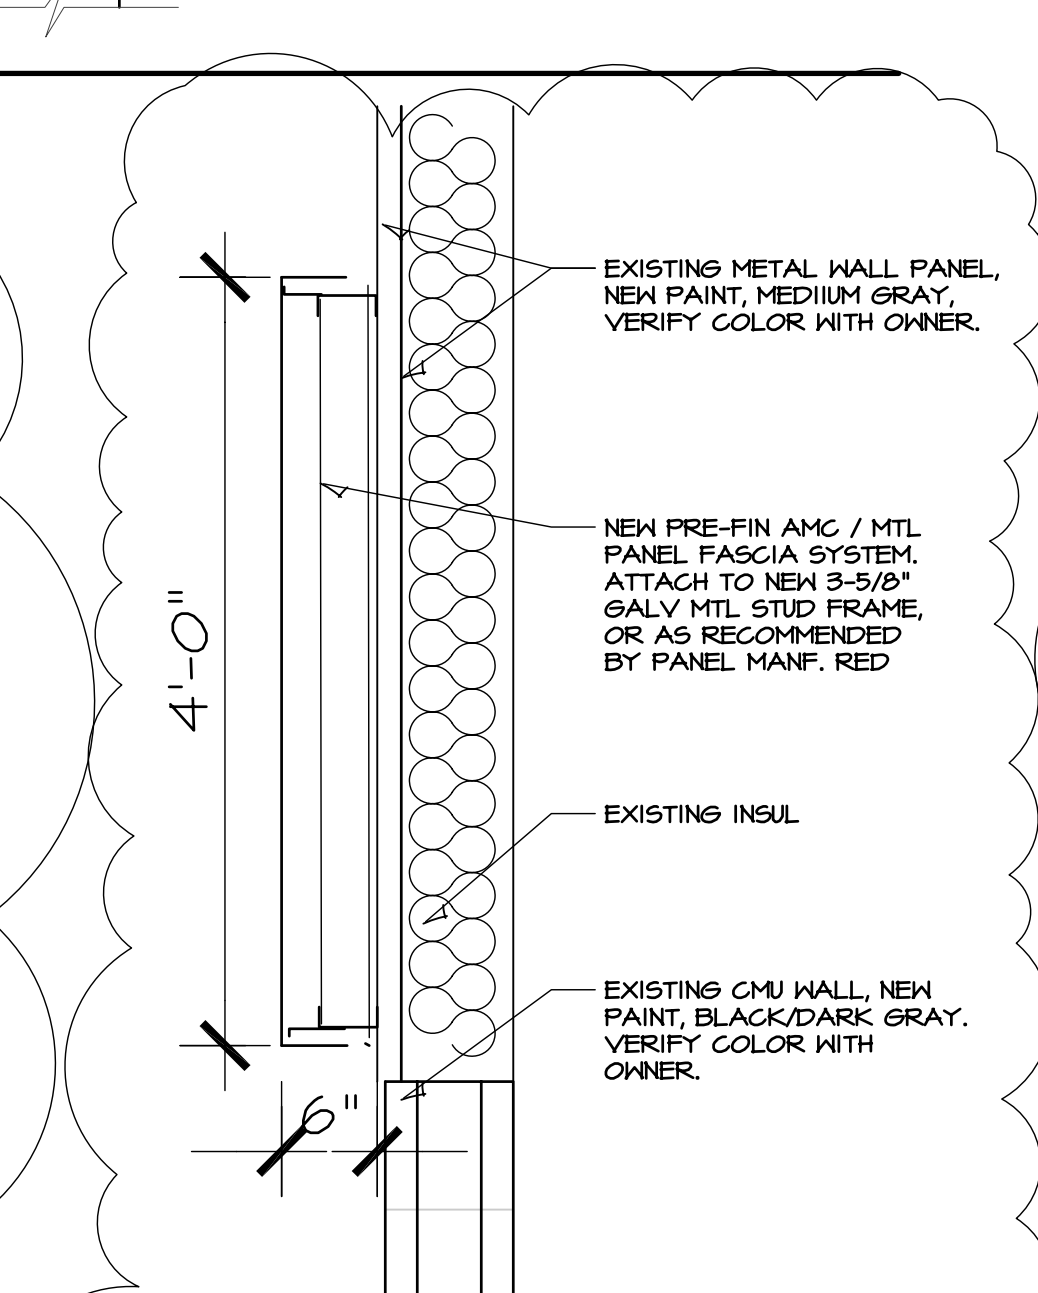


**4 FASCIA PANEL DETAIL**  
SCALE: 1/2" = 1'-0"

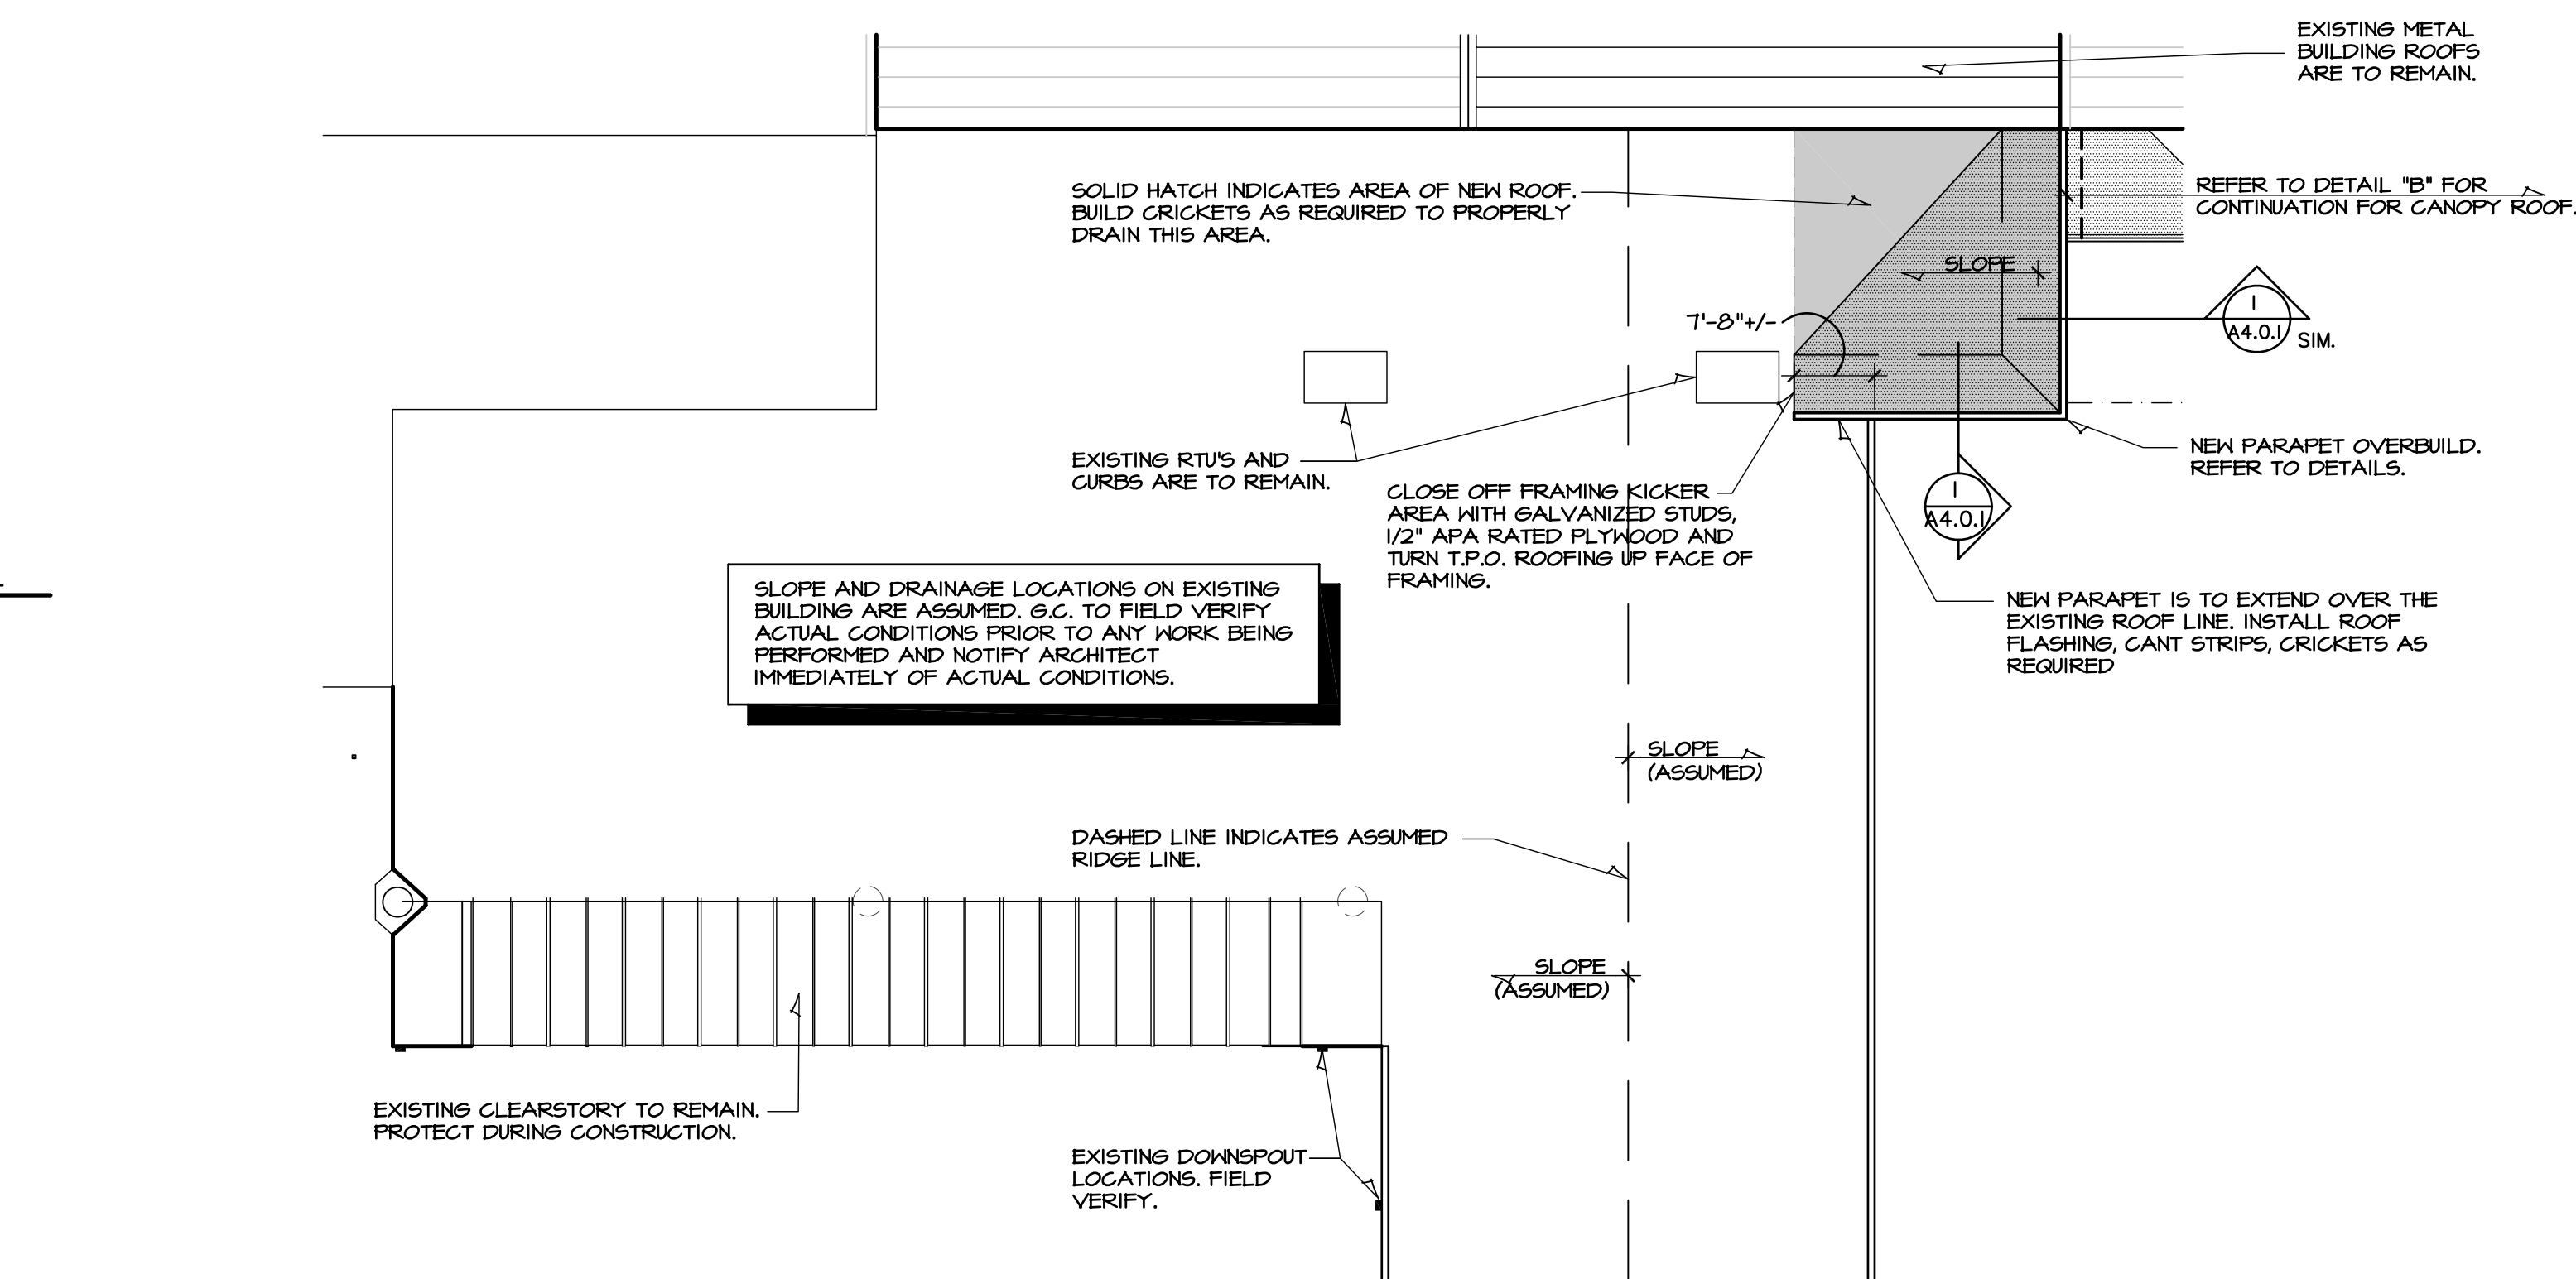


**A PARTIAL ROOF PLAN**  
SCALE: 1/16" = 1'-0"

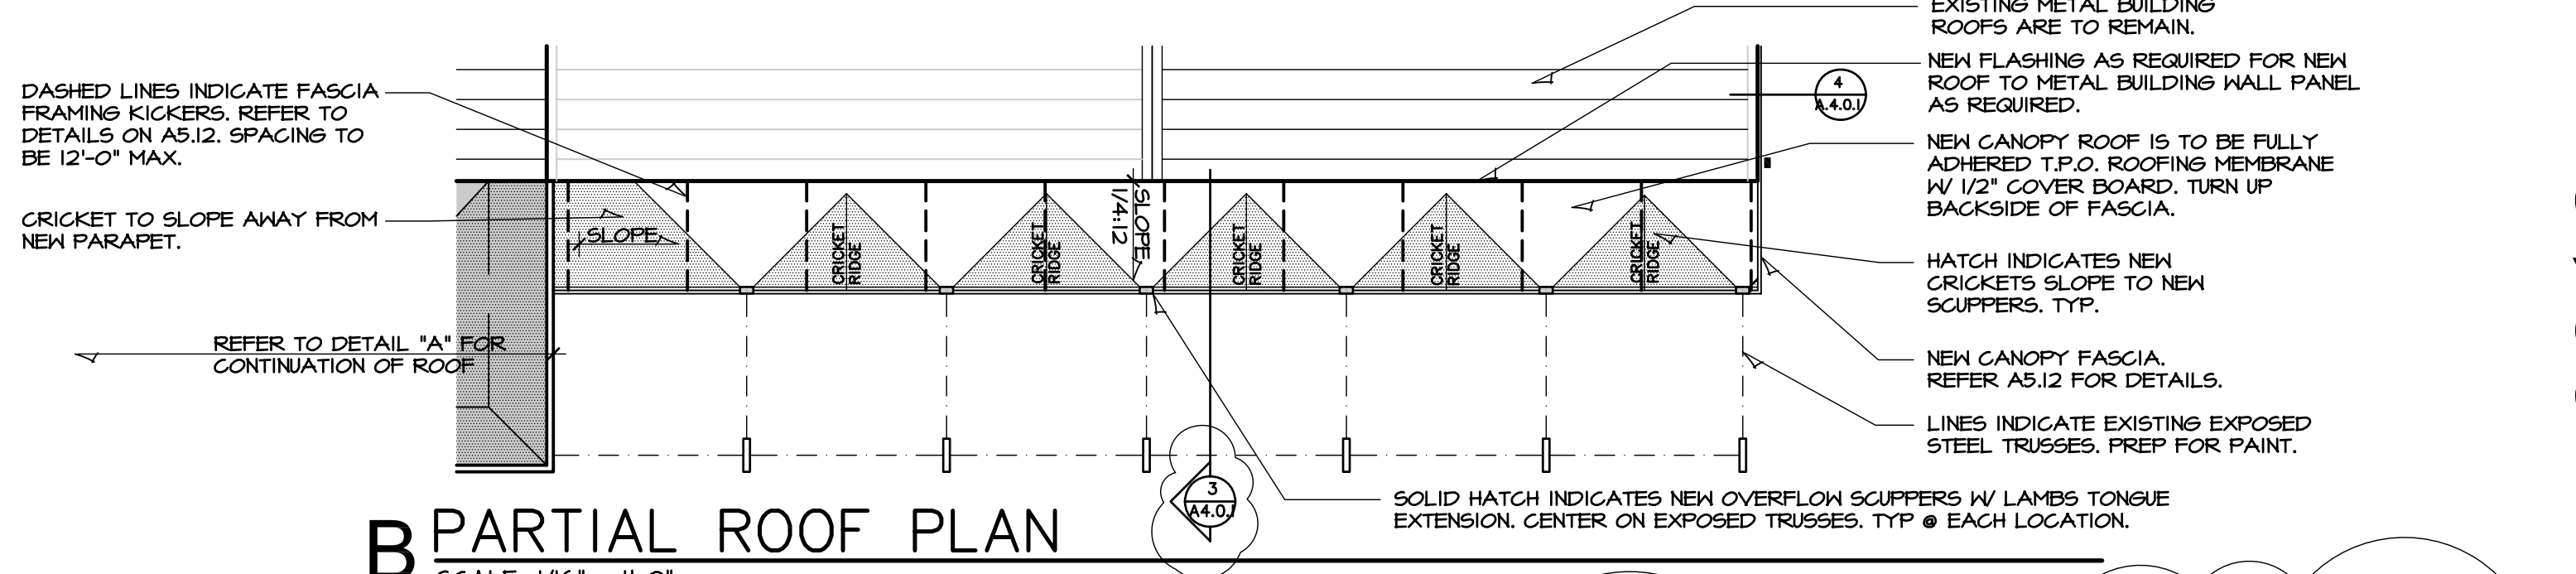

**B PARTIAL ROOF PLAN**  
SCALE: 1/16" = 1'-0"

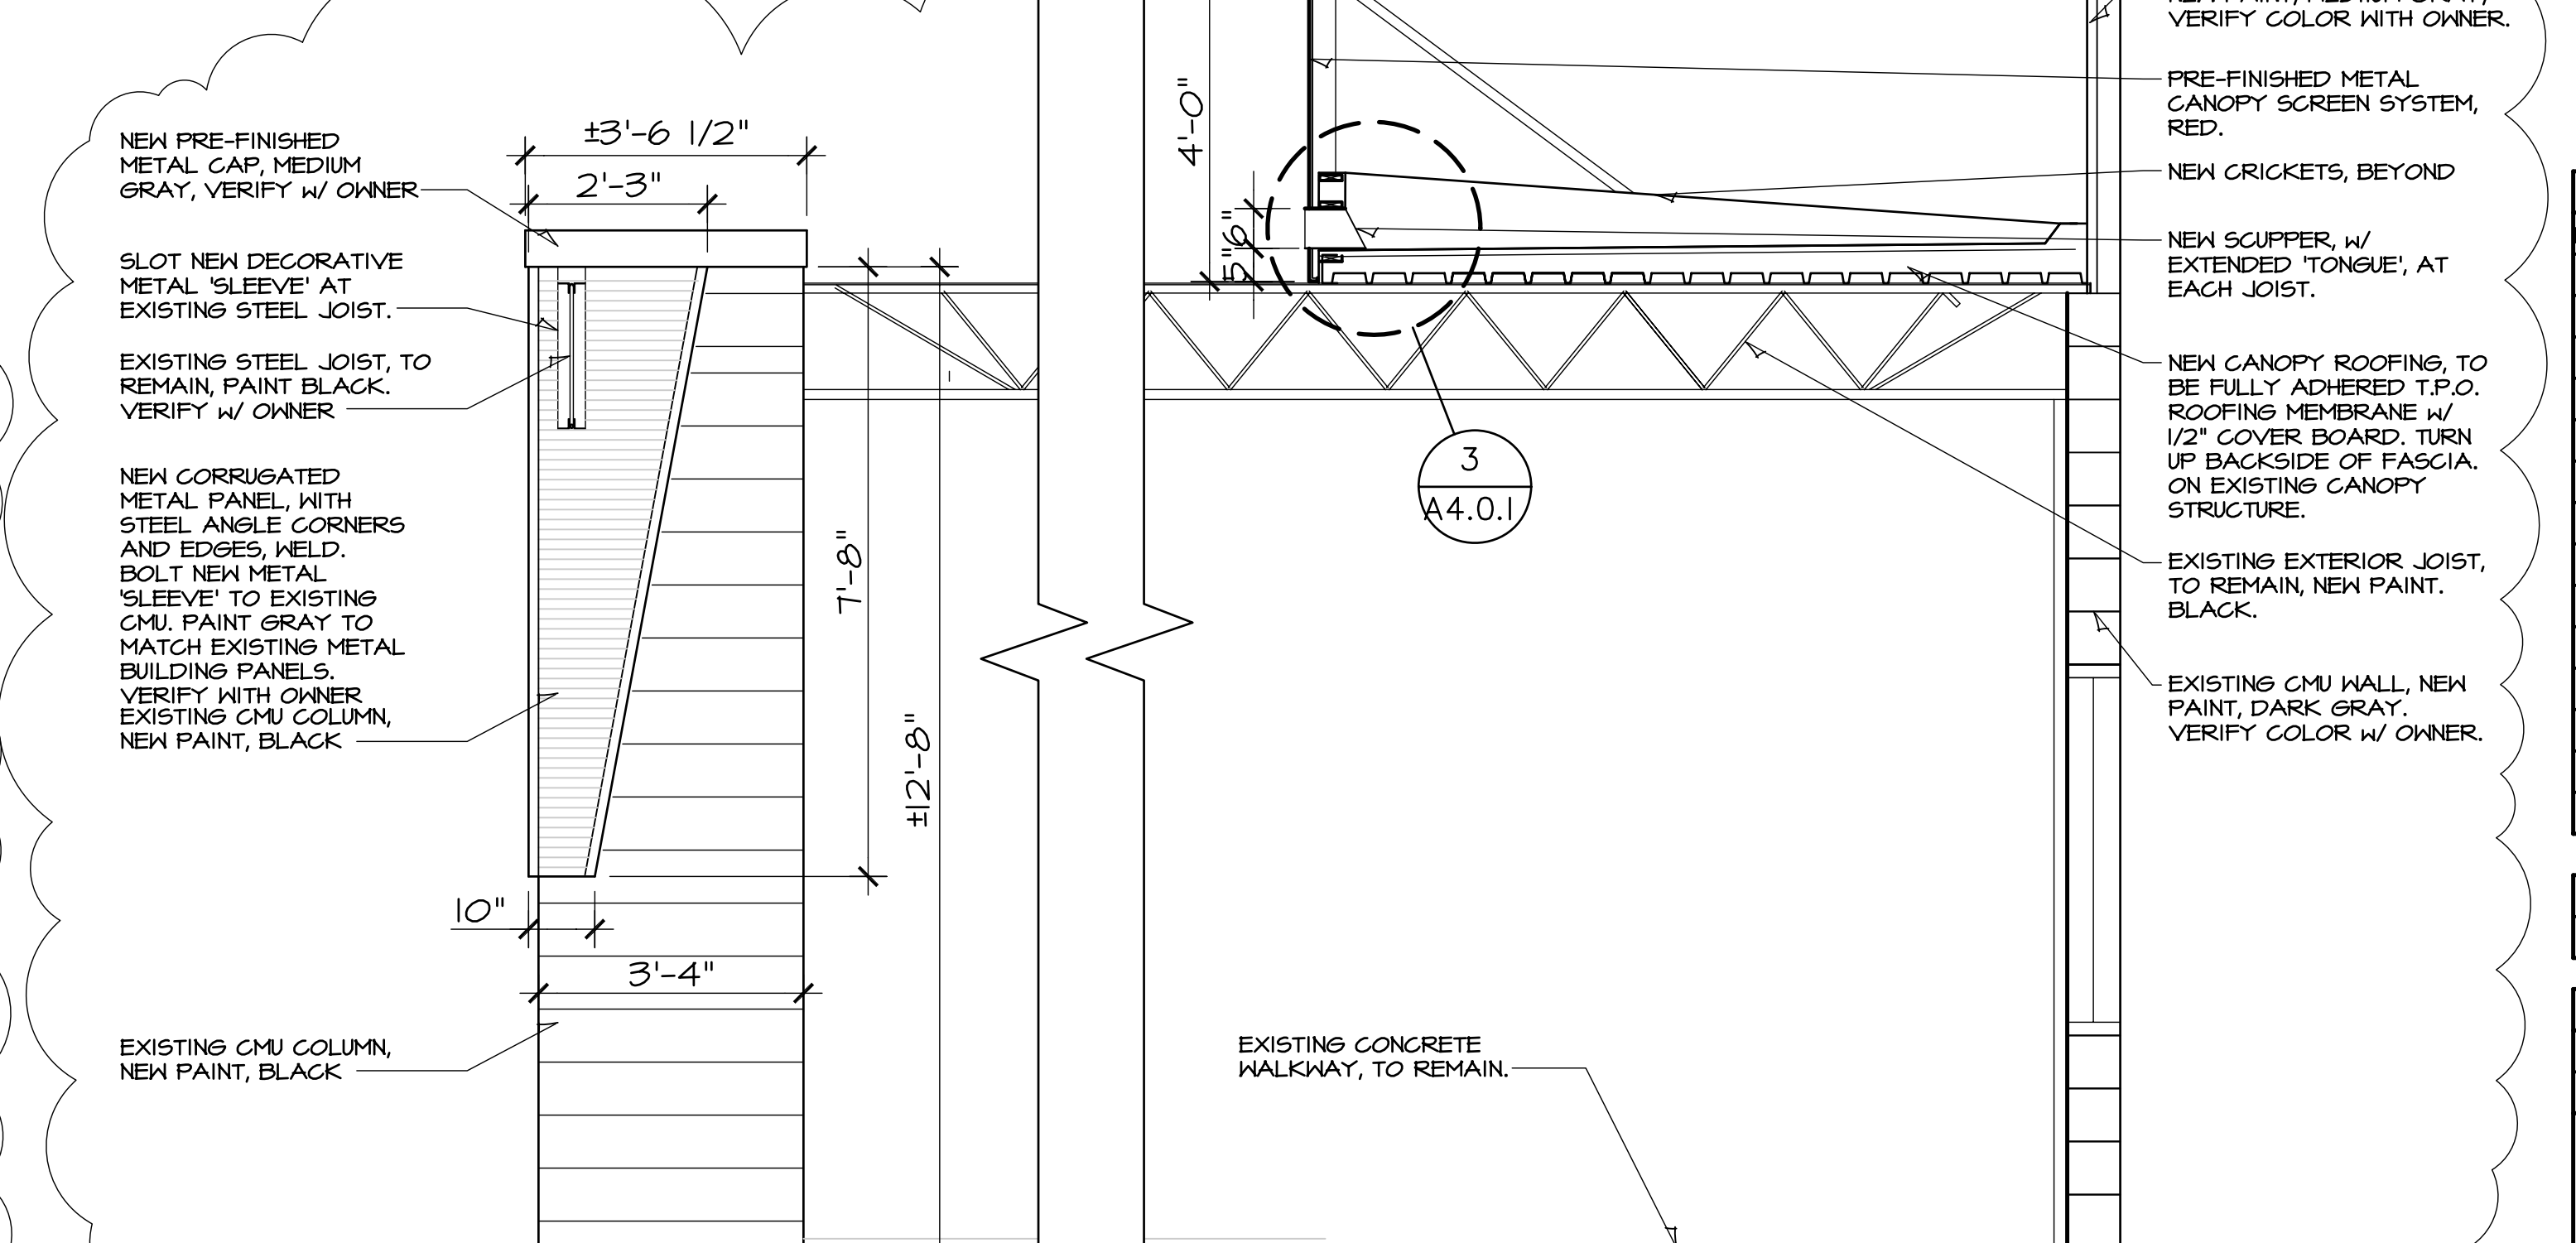

**3 CANOPY SECTION**  
SCALE: 1/2" = 1'-0"

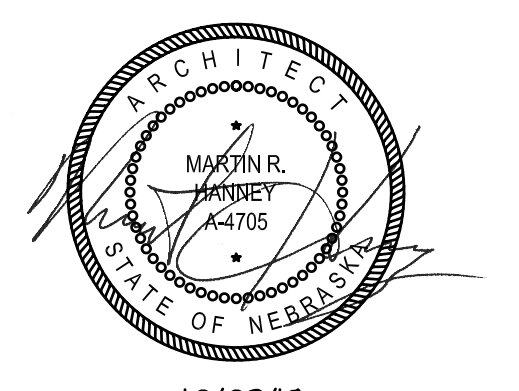

10/02/19  
**HANNWEY & ASSOCIATES ARCHITECTS**  
1726 South Hillsdale, Wichita, Kansas, 67211  
Phone (316) 683-8965  
Fax (316) 684-1441

**2019**  
**GENESIS HEALTH CLUBS WESTROADS**  
1212 NORTH 102ND STREET  
OMAHA, NE 68114



DRAWINGS ISSUED		
NO.	DATE	ITEM ISSUED
21	10/10/19	ADDENDA #3
20	10/02/19	ADDENDA #2
19	09/04/19	BID SET
18	09/03/19	CODE REVIEW
17	08/26/19	CODE REVIEW
16	08/11/19	CODE REVISIONS
15	06/17/19	CODE REVISIONS
14	04/22/19	PLAN REVIEW
13	02/18/19	REVIEW
12	01/29/19	REVIEW
11	01/08/19	REVISIONS
10	12/19/18	REVIEW
9	11/27/18	REVIEW

COMPUTER DRAWING  
GOE\_A4.0.1.dwg

DATE: APRIL 2019  
DRAWN BY: CHECKED BY:  
MH, CH, JC, MB MRH

SHEET  
**A4.0.1**  
OF SHEETS