





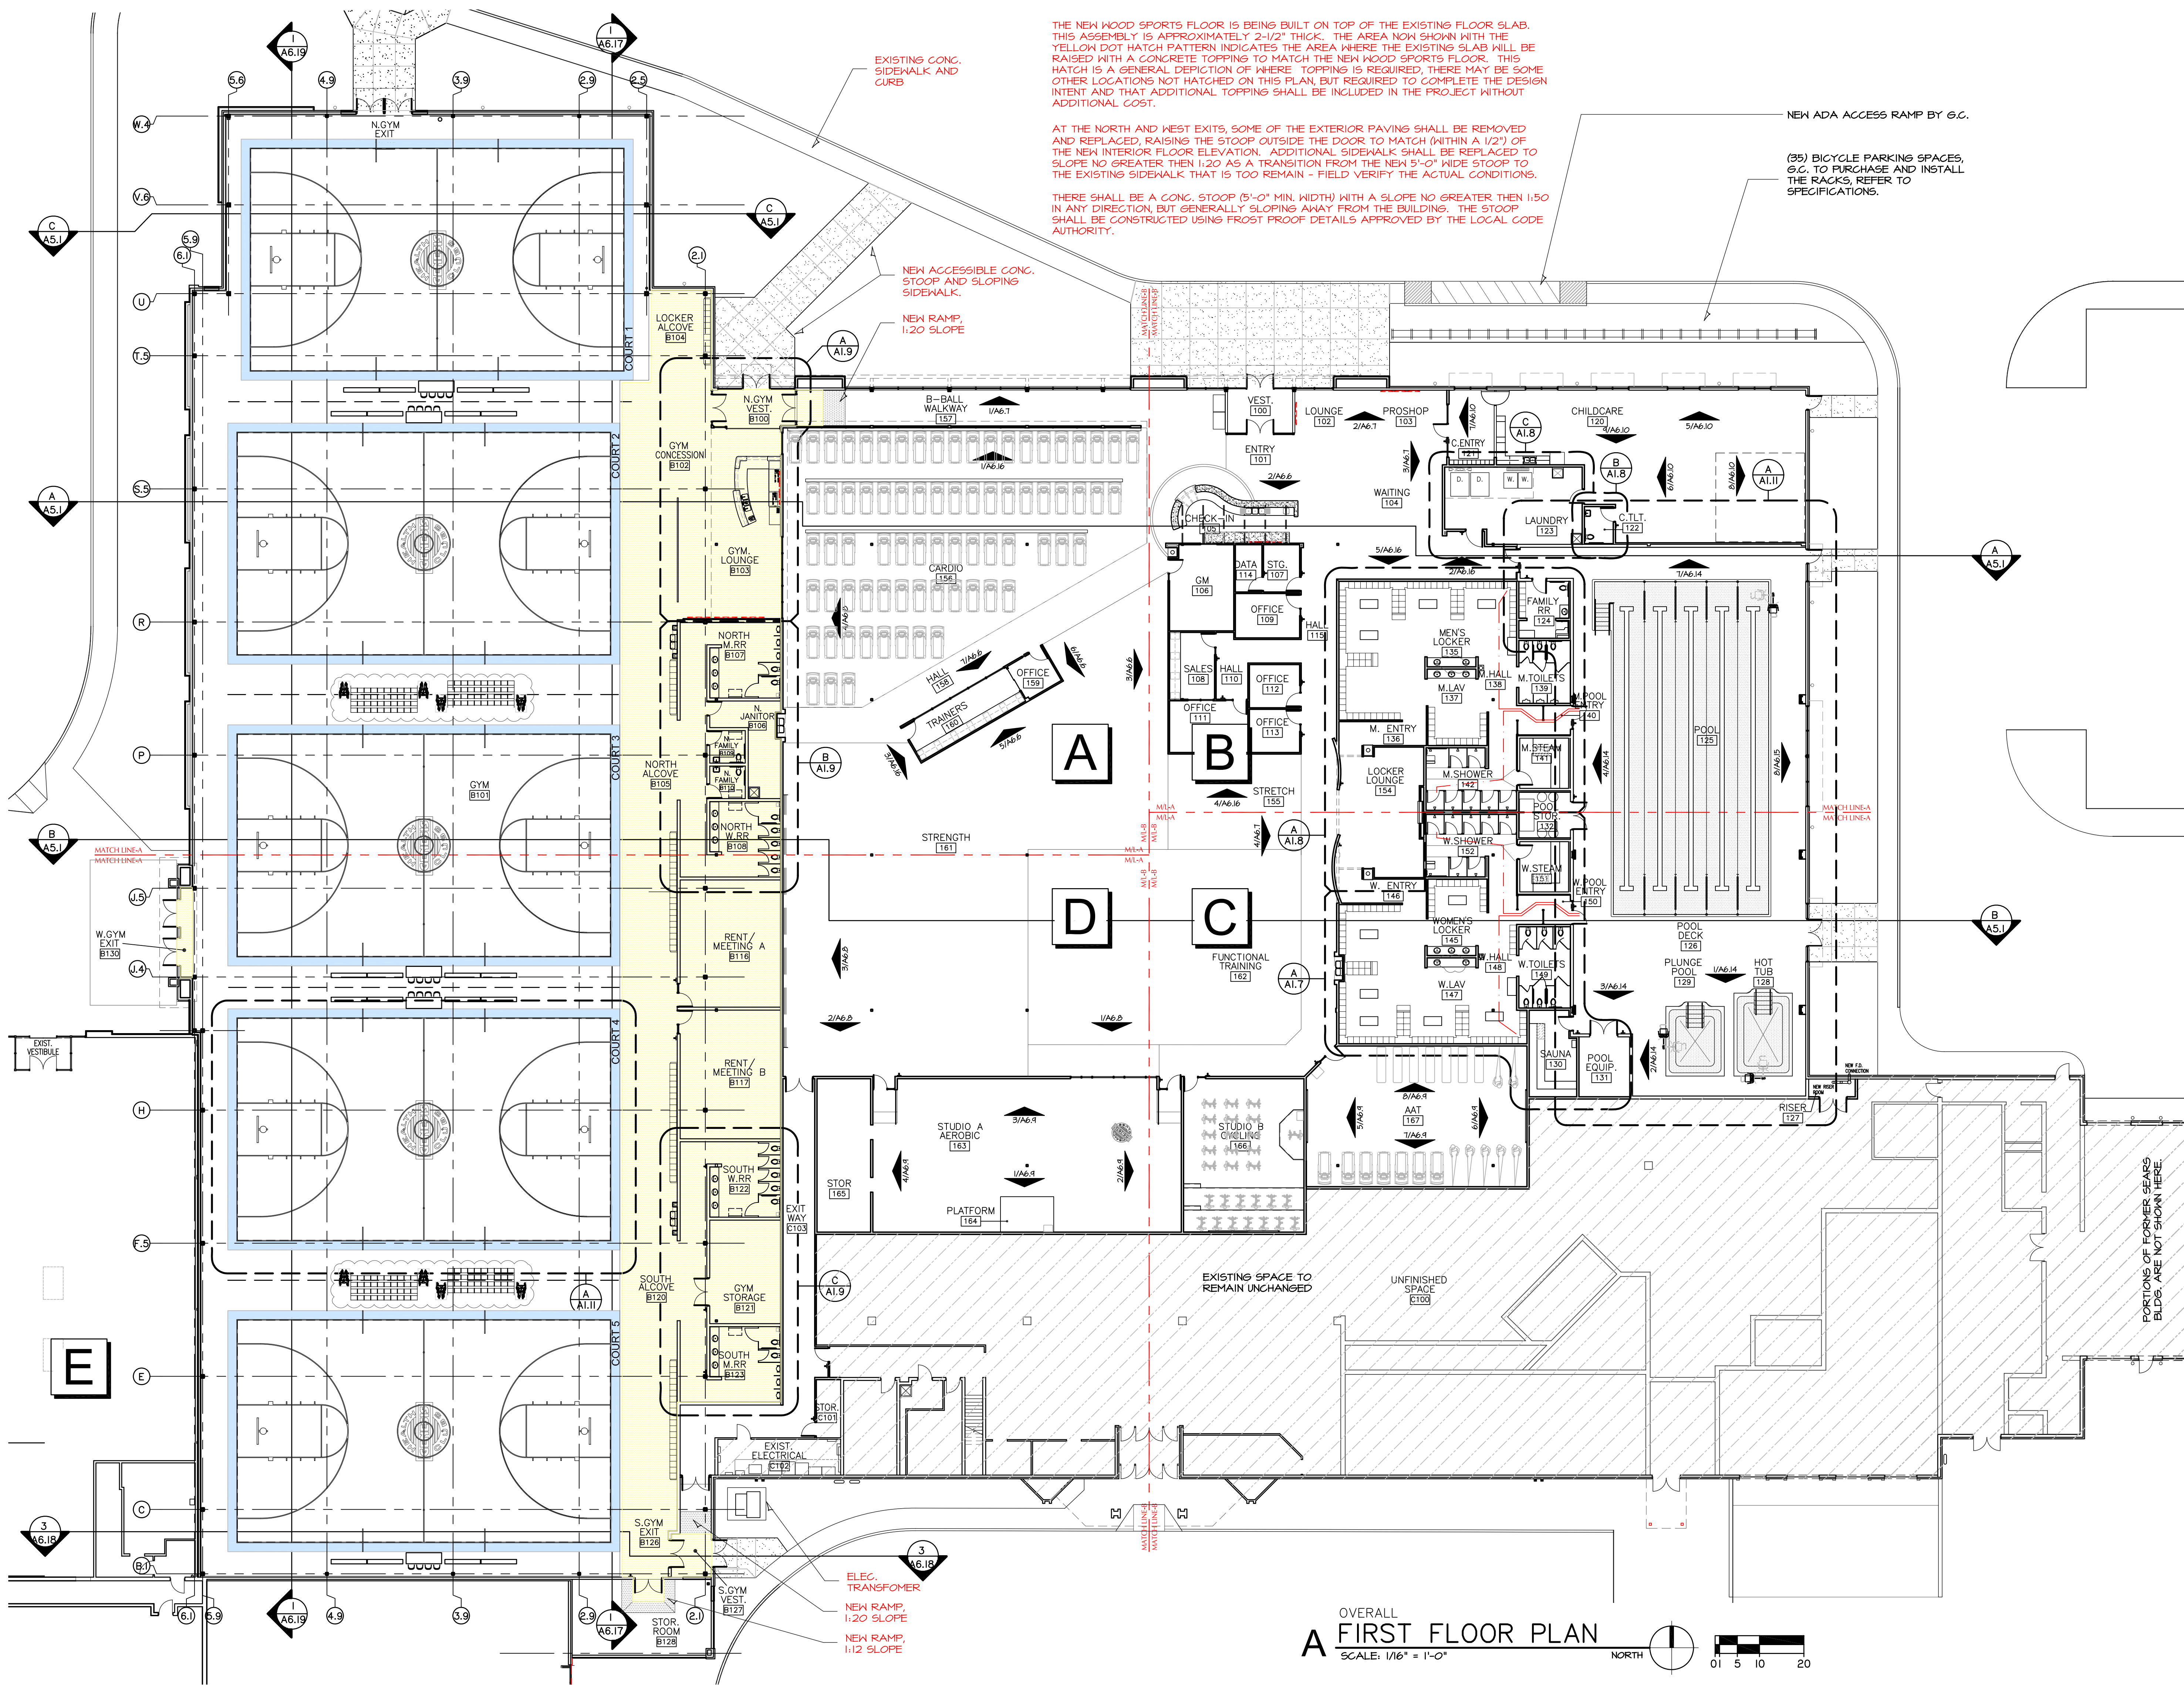

**HANNEY & ASSOCIATES, ARCHITECTS**  
1726 South Hillside, Wichita, Kansas 67211  
Phone (316) 683-8985  
Fax (316) 684-1441

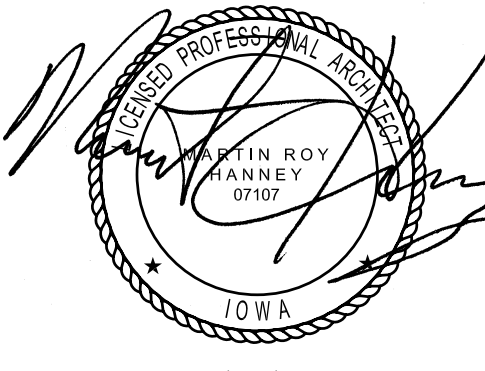

4/24/22

**2022 GENESIS HEALTH CLUBS**  
**SOUTHRIDGE MALL**  
1111 East Army Post Road  
Des Moines, Iowa 50315



| DRAWINGS ISSUED |          |                     |        |
|-----------------|----------|---------------------|--------|
| NO.             | DATE     | ITEM                | ISSUED |
| 11              | 4/24/22  | ADDENDUM 3          |        |
| 10              | 3/25/22  | CODE REVISIONS      |        |
| 9               | 2/11/22  | PERMIT SET          |        |
| 8               | 1/25/22  | CHECK SET           |        |
| 7               | 12/15/21 | CHECK SET           |        |
| 6               | 9/24/21  | CHECK SET           |        |
| 5               | 8/21/21  | SITE PLAN REVIEW    |        |
| 4               | 7/21/21  | UDRB SUBMITTAL      |        |
| 3               | 1/08/21  | MILESTONE DEV. PLAN |        |
| 2               | 5/25/21  | CONCEPT, DEV. PLAN  |        |
| 1               | 3/20/21  | CONCEPT, DEV. PLAN  |        |

COMPUTER DRAWING  
DMS\_A101.dwg

DATE: AUGUST 2021  
DRAWN BY: CHECKED BY:  
MH, CH, DH, TH, TC MRH

SHEET  
**A1.1**  
OF - SHEETS