

4/12/22
HANNAY & ASSOCIATES, ARCHITECTS
 1728 South Hillside, Wichita, Kansas, 67211
 Phone (316) 683-8985
 Fax (316) 684-1441

2022
GENESIS HEALTH CLUBS
SOUTHBRIDGE MALL
 1111 East Army Post Road
 Des Moines, Iowa 50315





DRAWINGS ISSUED		
NO.	DATE	ITEM ISSUED
10	4/12/22	ADDENDUM I
4	2/1/22	PERMIT SET
8	1/25/22	CHECK SET
7	12/15/21	CHECK SET
6	9/24/21	CHECK SET
5	8/21/21	SITE PLAN REVIEW
4	7/21/21	UDRB SUBMITTAL
3	7/08/21	MILESTONE DEV. PLAN
2	5/25/21	CONCEPT. DEV. PLAN
1	3/20/21	CONCEPT. DEV. PLAN

COMPUTER DRAWING
 DMS_A209.dwg

DATE: AUGUST 2021
 DRAWN BY: CHECKED BY:
 MH, CH, DH, TH, TC MRH

SHEET
A2.9
 OF SHEETS

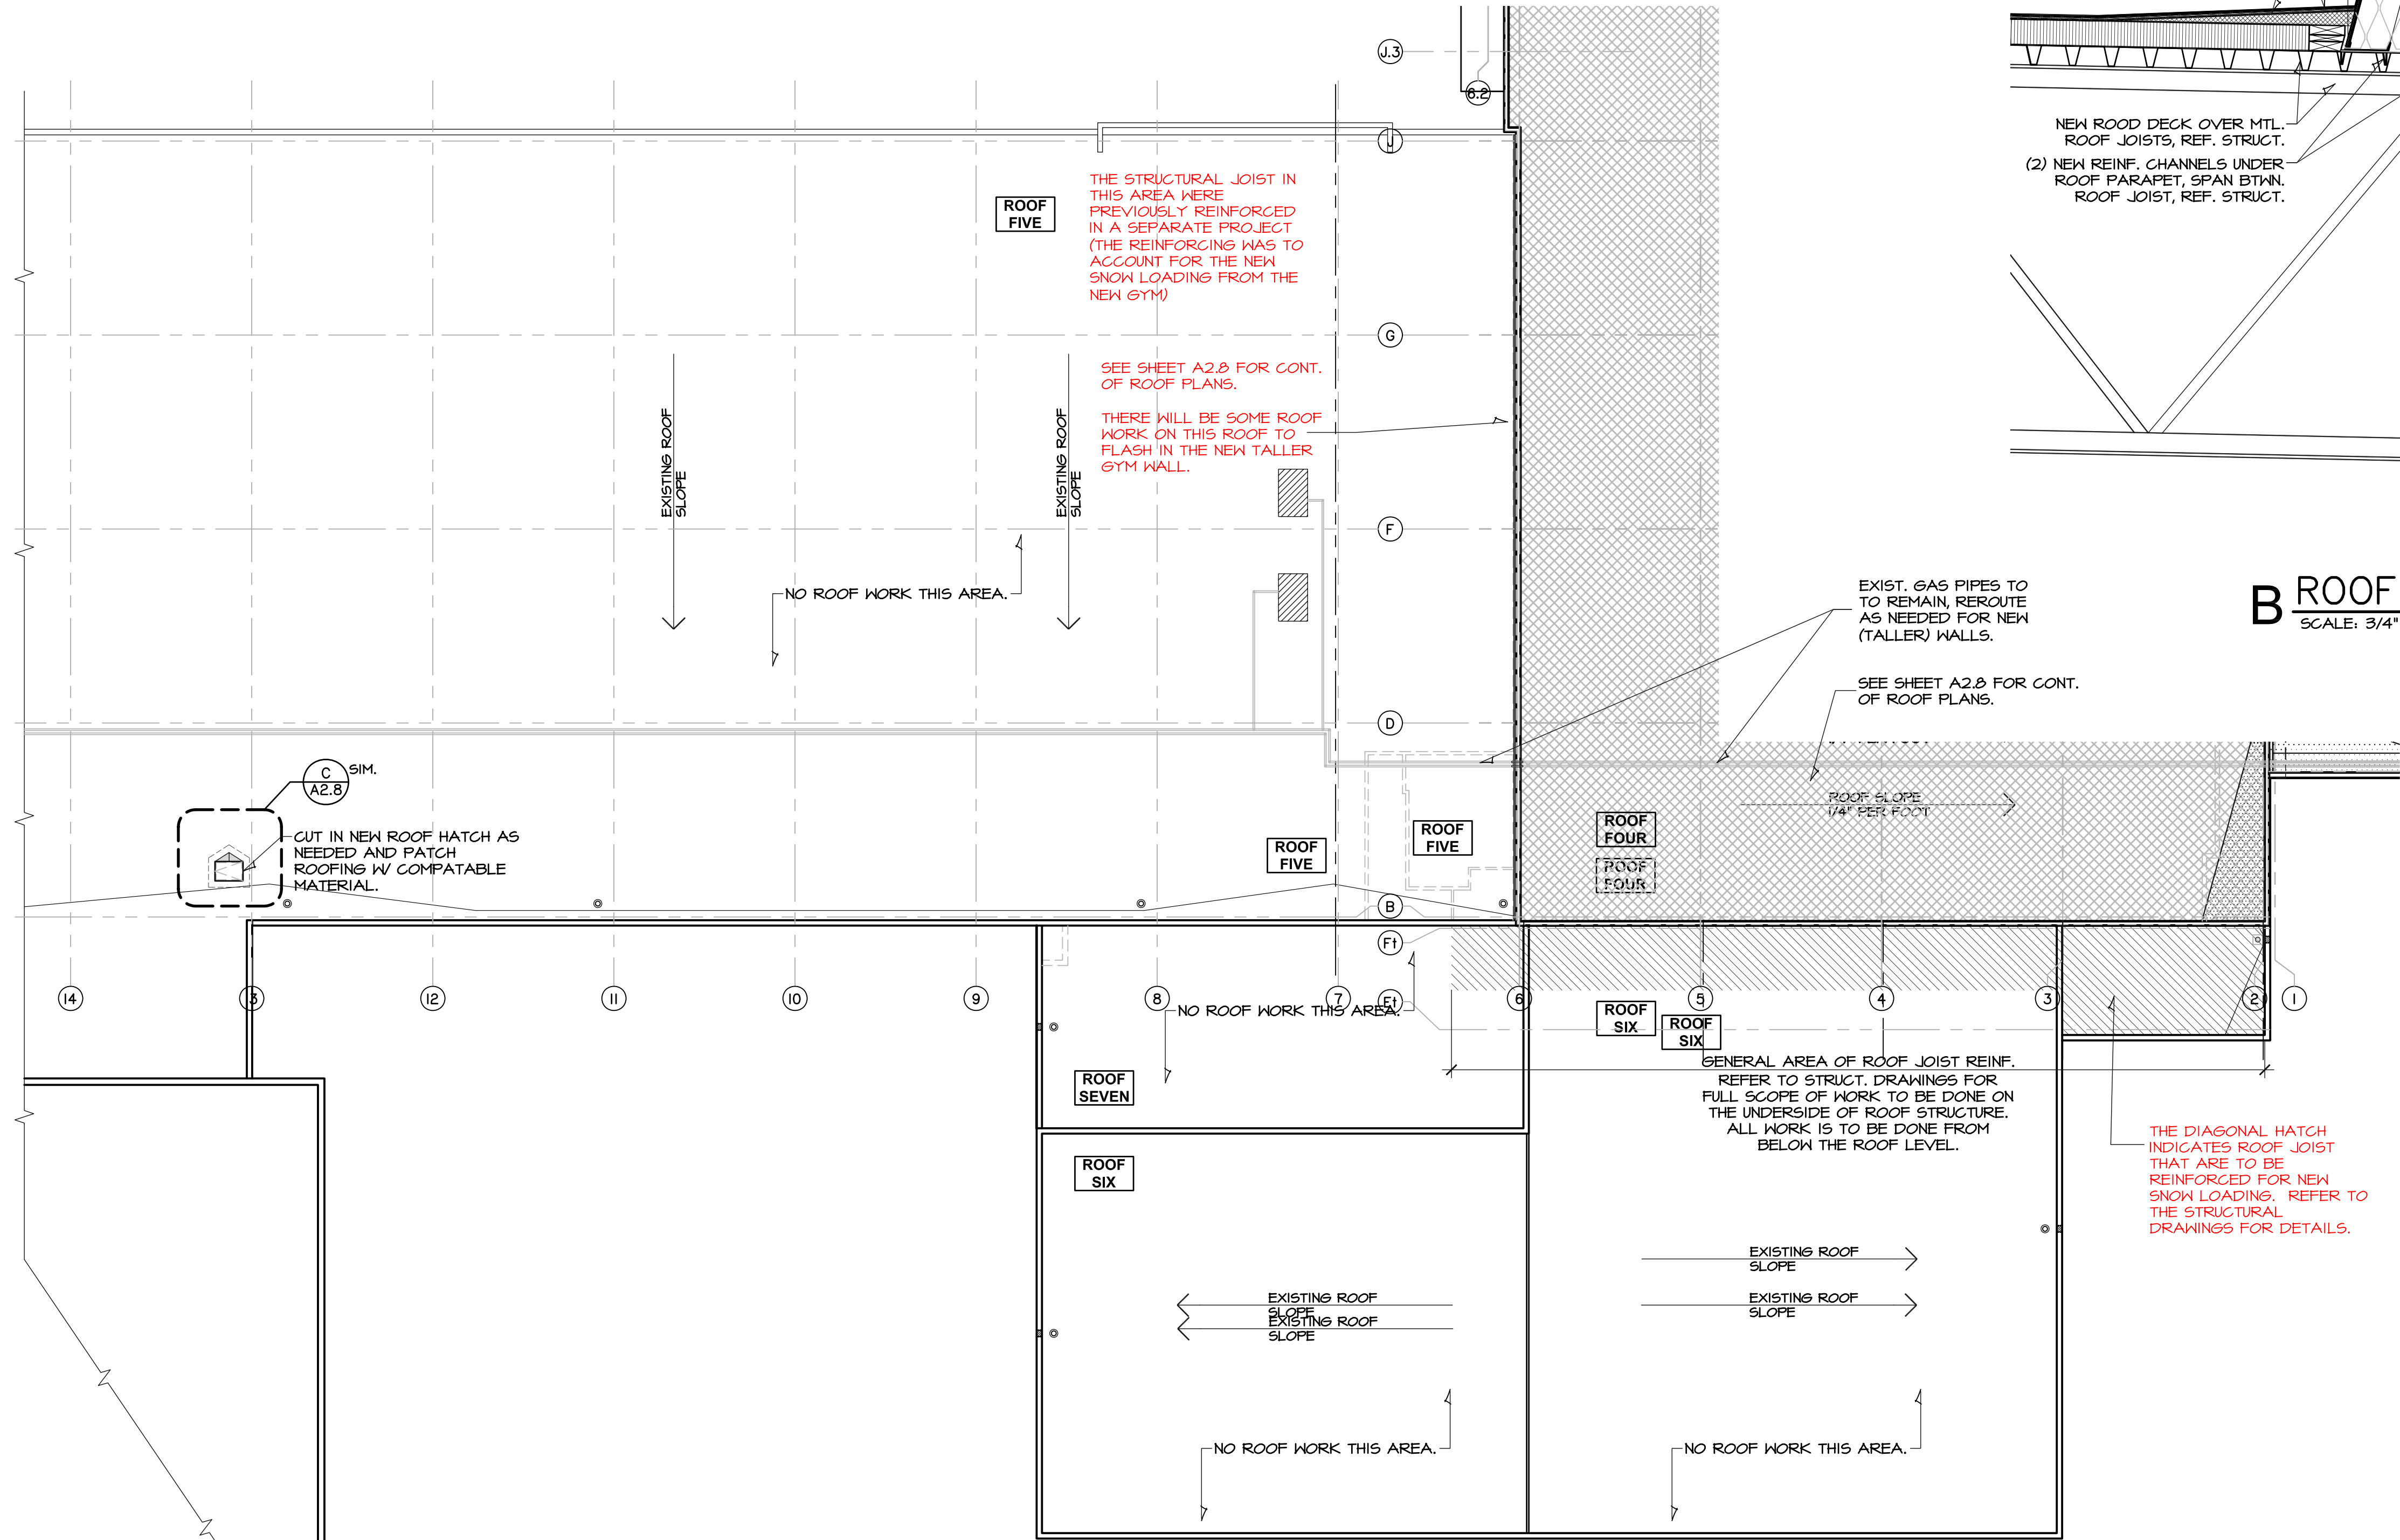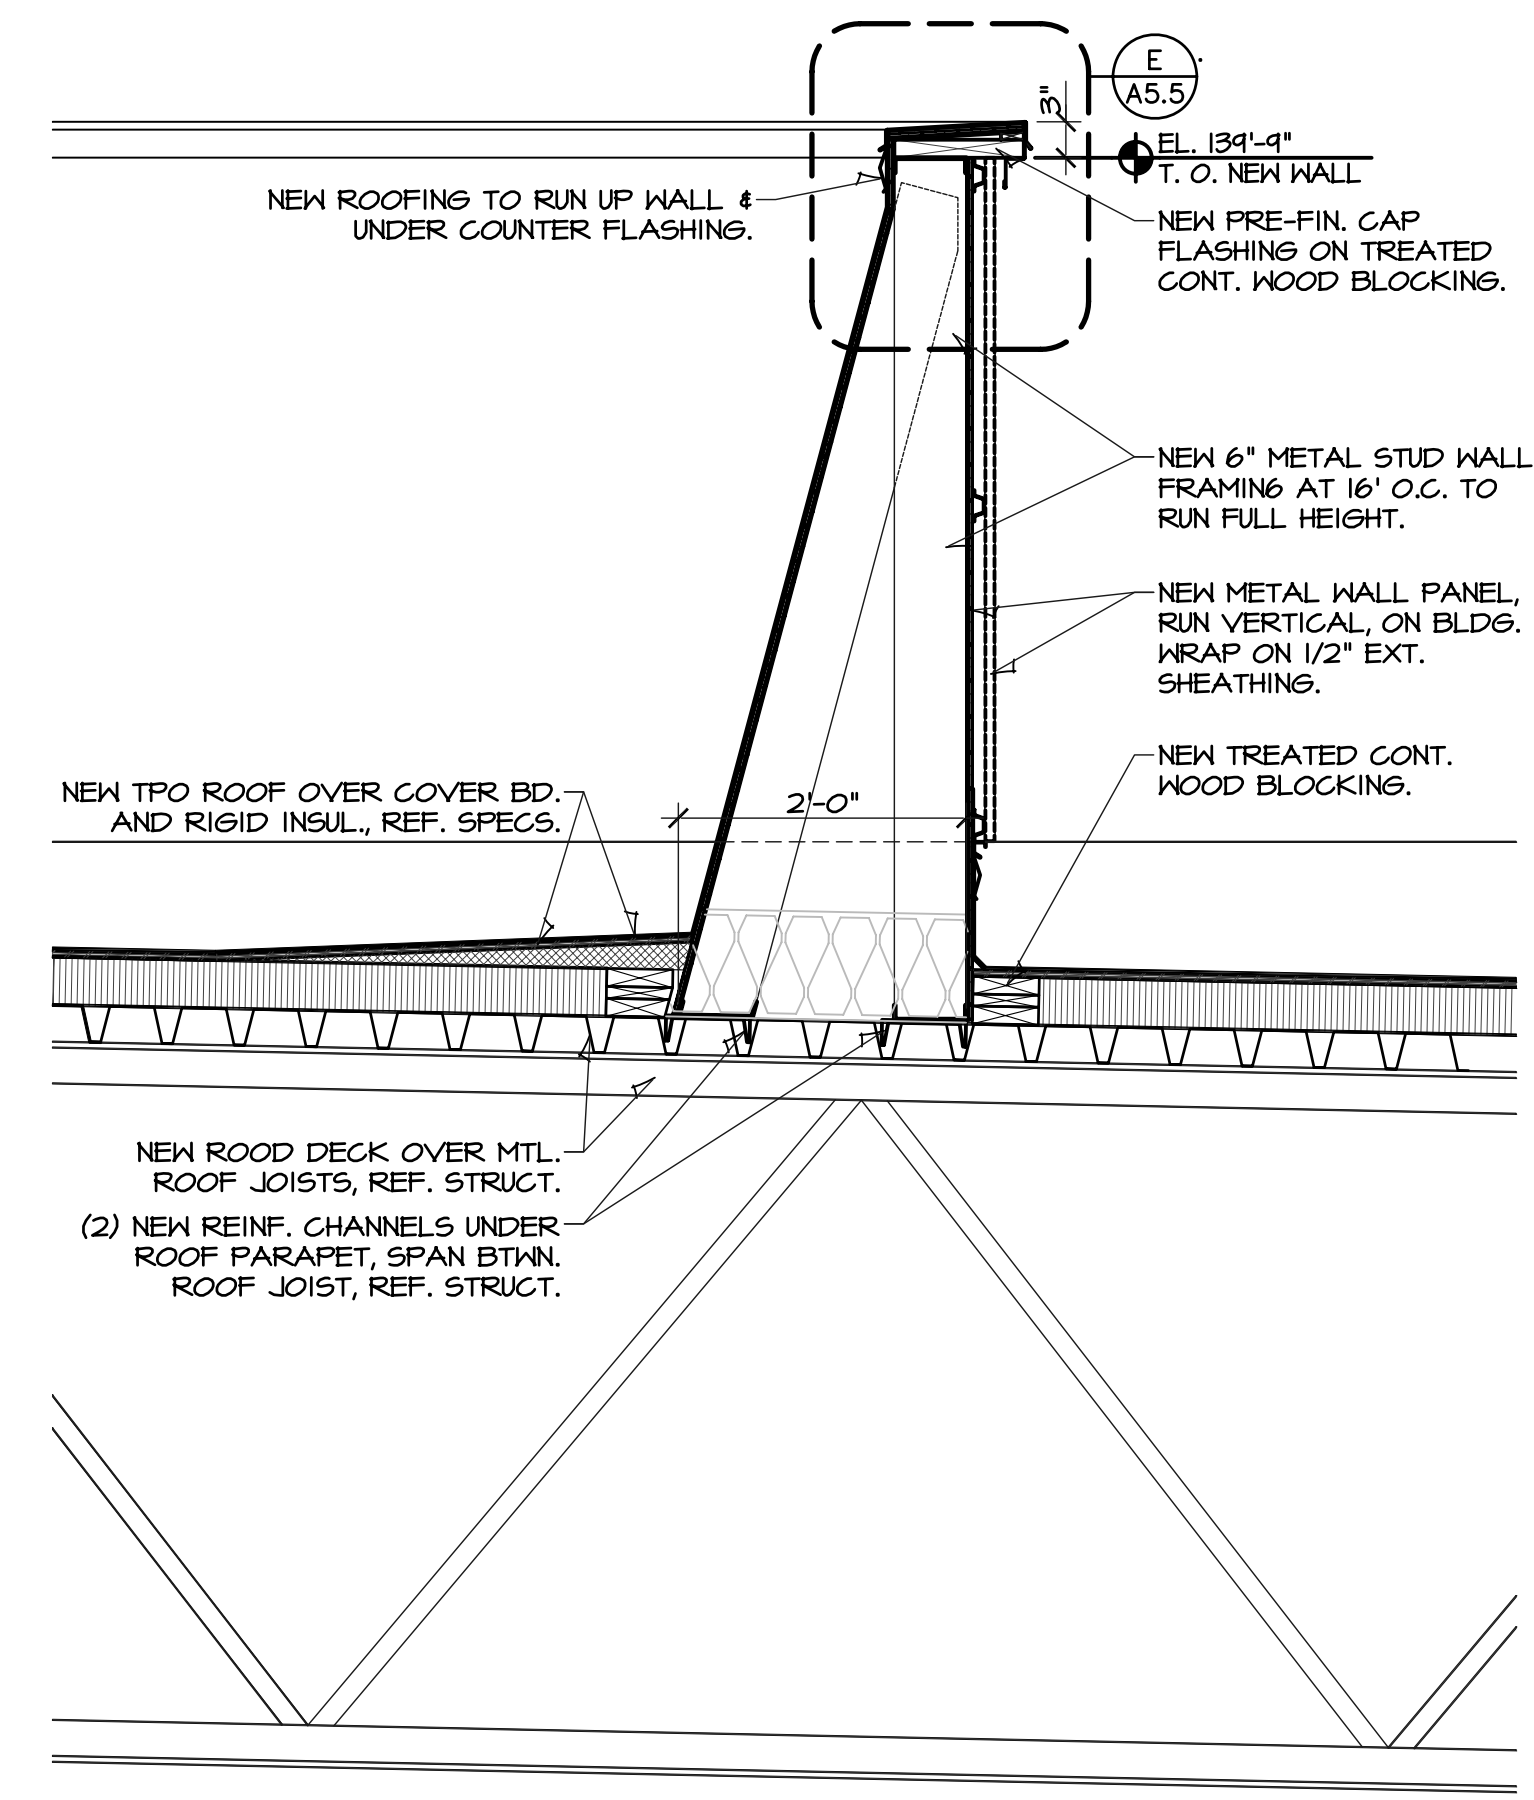

ROOF AREAS 5 & 6
A ROOF PLAN
 SCALE: 1/16" = 1'-0"
 NORTH
 01 5 10 20