



**1 EAST BASKETBALL
REFERENCE ELEVATION**
SCALE: N.T.S.

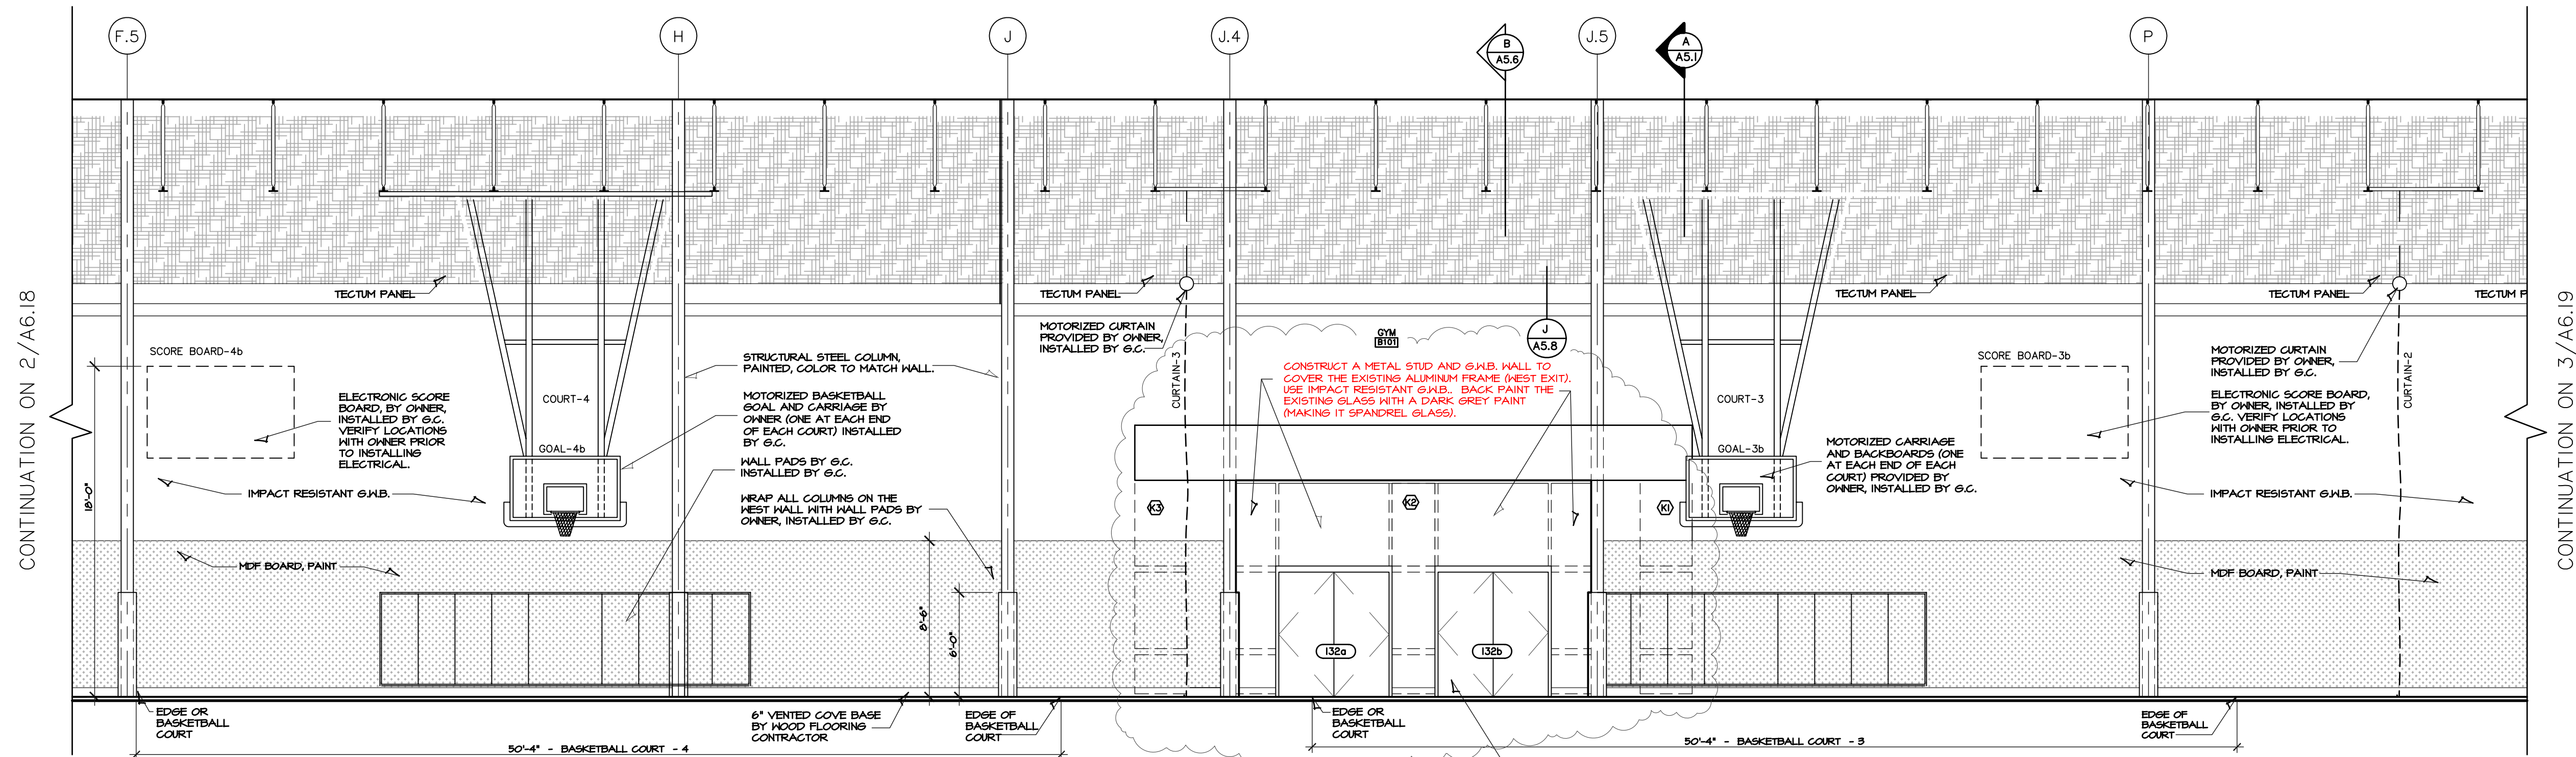


**2 WEST BASKETBALL
ENLARGED ELEVATION**
SCALE: 3/16" = 1'-0"

EXISTING ALUM. FRAMES "K1", "K2" AND "K3" SHALL BE MODIFIED DUE TO RAISING THE FLOOR 2'-1/2" +/- . ALL GLASS THAT IS TO BE REPLACED SHALL BE 1" THICK SPANDREL GLASS.
THE ALUMINUM AND GLASS DOORS SHALL BE REPLACED WITH NEW HOLLOW METAL DOORS (PAINTED FINISH).
THE EXISTING GLAZING SHALL BE BACK PAINTED WITH DARK GREY PAINT, MAKING IT A SPANDREL GLASS.
FRAME A NEW WALL BEHIND THE EXISTING ALUMINUM FRAMES (6" METAL STUDS @ 16" O.C. AND INSULATED WITH 6" BATT, COVER WITH 5/8" TYPE "X" G.W.B.

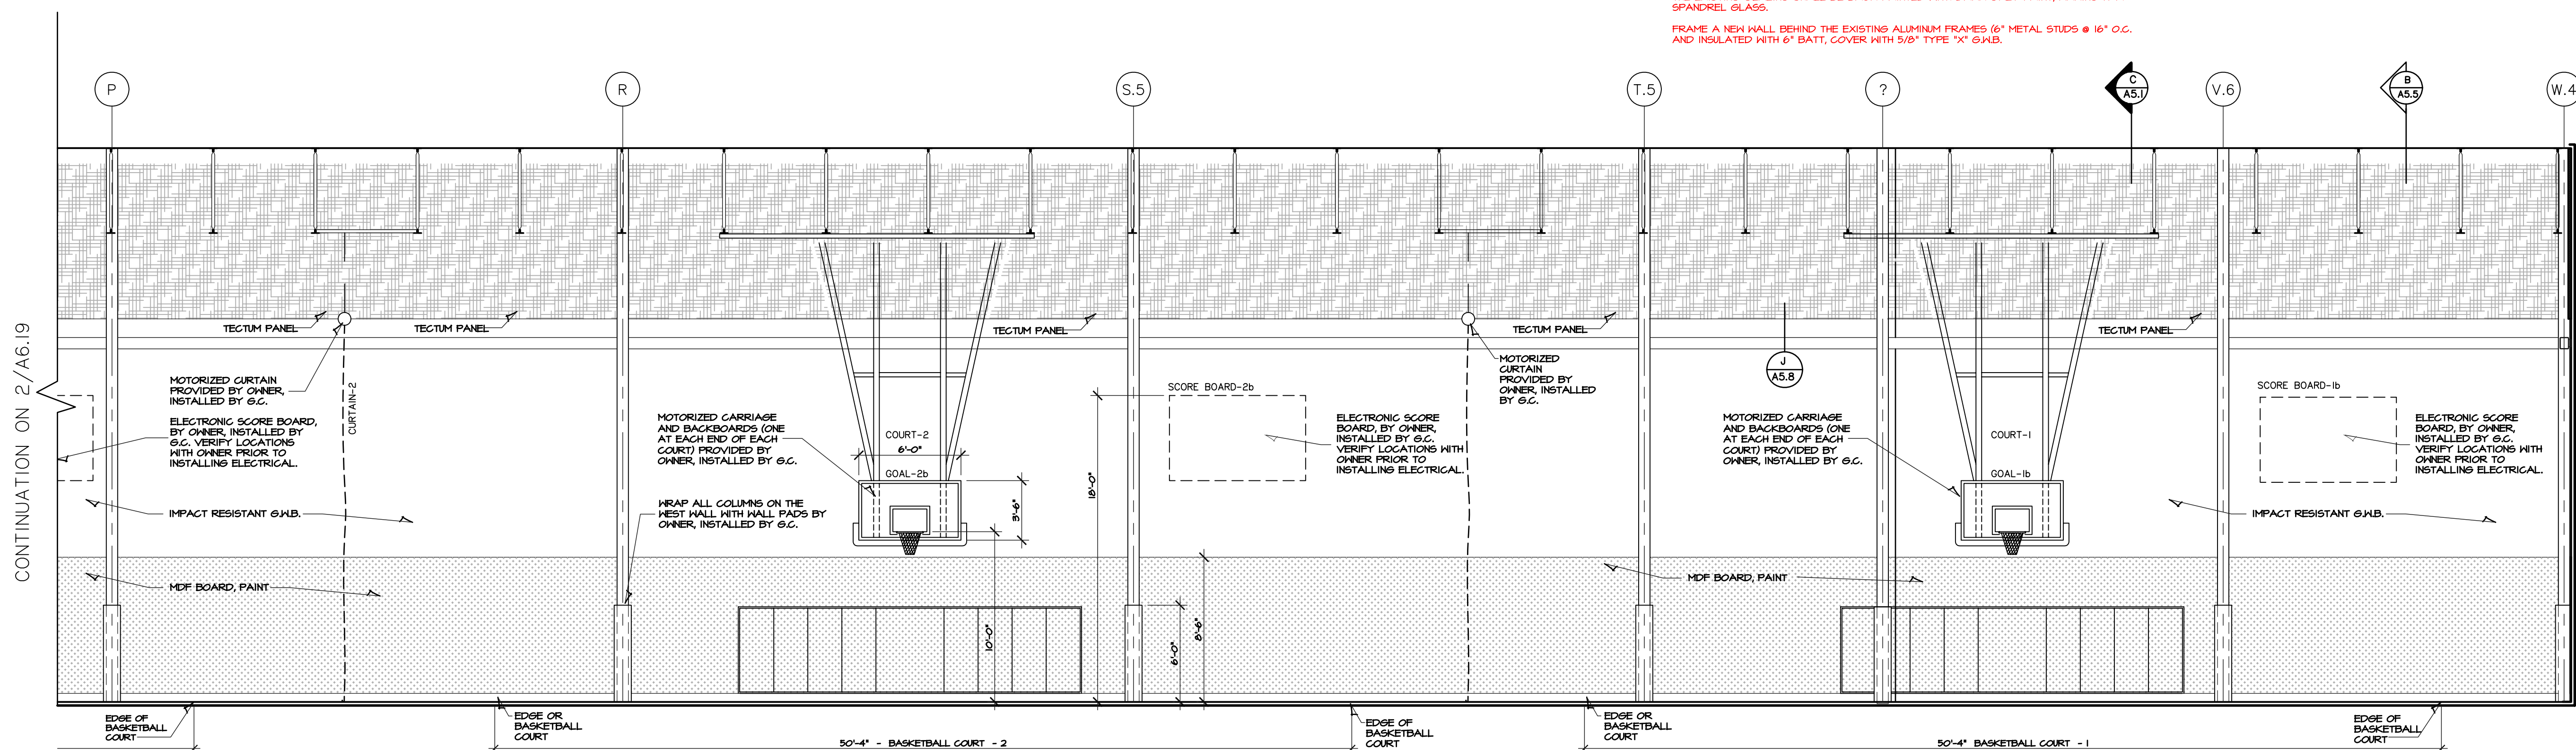

**3 WEST BASKETBALL
ENLARGED ELEVATION**
SCALE: 3/16" = 1'-0"

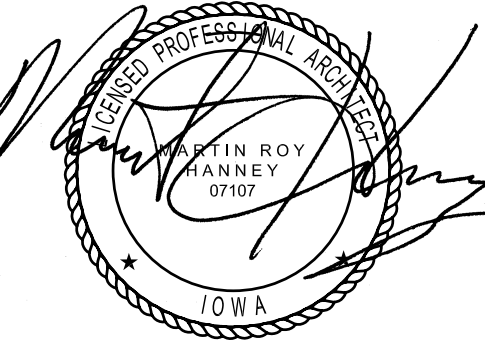

4/24/22
HANNEY & ASSOCIATES, ARCHITECTS
1726 South Hillside, Wichita, Kansas, 67211
Phone (316) 683-8985
Fax (316) 684-1441

2022 GENESIS HEALTH CLUBS
SOUTHBRIDGE MALL
1111 East Army Post Road
Des Moines, Iowa 50315



DRAWINGS ISSUED			
NO.	DATE	ITEM	ISSUED
10	4/24/22	ADDENDUM 3	
9	2/11/22	PERMIT SET	
8	1/25/22	CHECK SET	
7	12/15/21	CHECK SET	
6	9/24/21	CHECK SET	
5	8/21/21	SITE PLAN REVIEW	
4	7/21/21	UDRB SUBMITTAL	
3	1/08/21	MILESTONE DEV. PLAN	
2	5/25/21	CONCEPT, DEV. PLAN	
1	3/20/21	CONCEPT, DEV. PLAN	

COMPUTER DRAWING
DMS_619.dwg

DATE: AUGUST 2021
DRAWN BY: CHECKED BY:
MH, CH, DH, TH, TC MRH

SHEET
A6.19
OF - SHEETS