



**A CHECK-IN DESK BAR HEIGHT COUNTER PLAN**  
SCALE: 3/4"=1'-0"

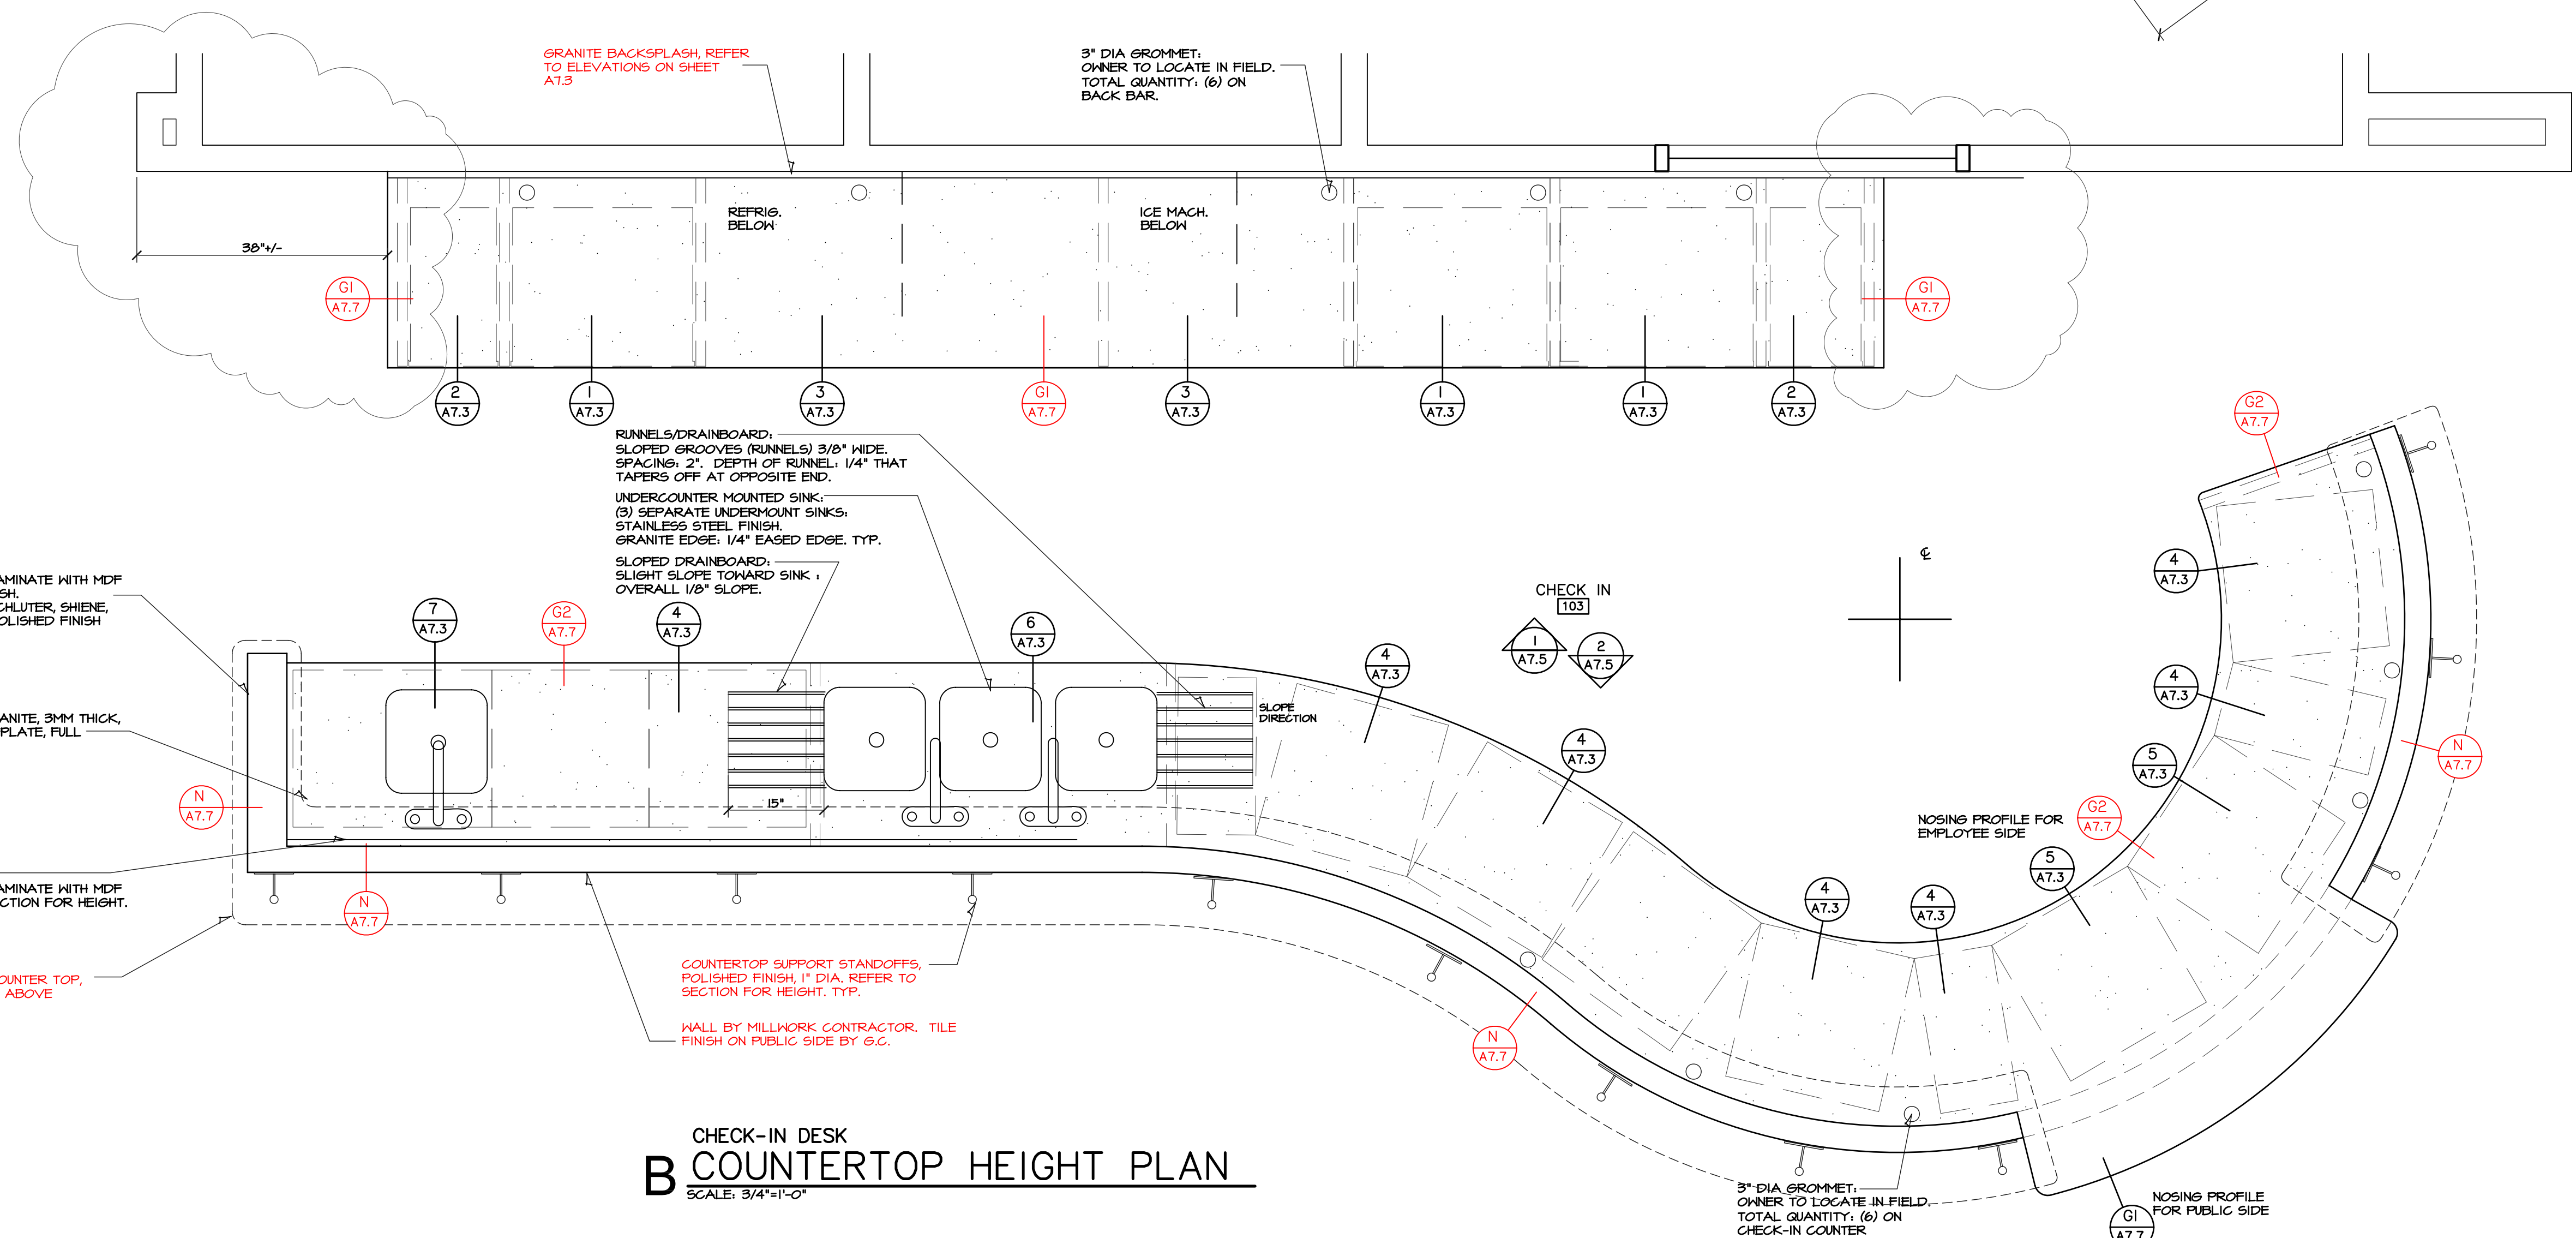

**B CHECK-IN DESK COUNTERTOP HEIGHT PLAN**  
SCALE: 3/4"=1'-0"

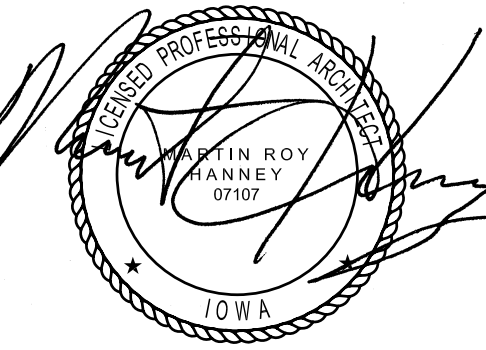

4/24/22  
**HANNAY & ASSOCIATES, ARCHITECTS**  
1726 South Hillside, Wichita, Kansas, 67211  
Phone (316) 683-8985  
Fax (316) 684-1441

**2022 GENESIS HEALTH CLUBS**  
SOUTHBRIDGE MALL  
1111 East Army Post Road  
Des Moines, Iowa 50315



DRAWINGS ISSUED			
NO.	DATE	ITEM	ISSUED
10	4/24/22	ADDENDUM 3	
9	2/11/22	PERMIT SET	
8	1/25/22	CHECK SET	
7	12/15/21	CHECK SET	
6	9/24/21	CHECK SET	
5	8/21/21	SITE PLAN REVIEW	
4	1/21/21	UDRB SUBMITTAL	
3	1/08/21	MILESTONE DEV. PLAN	
2	5/25/21	CONCEPT. DEV. PLAN	
1	3/20/21	CONCEPT. DEV. PLAN	

**COMPUTER DRAWING**  
DMS\_A701.dwg

DATE: AUGUST 2021  
DRAWN BY: CHECKED BY:  
MH, CH, DH, TH, TC MRH

SHEET  
**A7.1**  
OF SHEETS