WALL PATTERN DETAILS

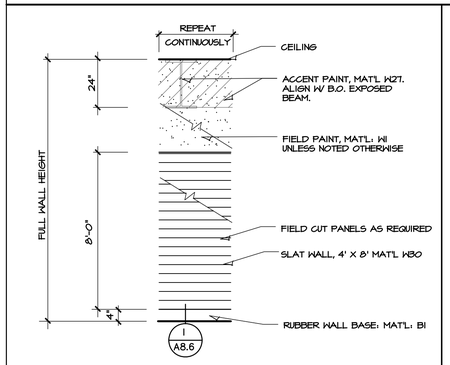

1 PROSHOP DISPLAY WALL
INWALL BLOCKING TO SUPPORT FUNCTION OF DISPLAY WALL.
CONCEAL ATTACHMENT OF PANELS

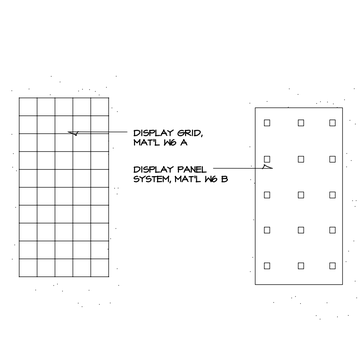

2 ALTERNATE DISPLAY WALL MATERIALS
INWALL BLOCKING TO SUPPORT FUNCTION OF DISPLAY WALL.
CONCEAL ATTACHMENT OF PANELS. OWNER TO ID LOCATION

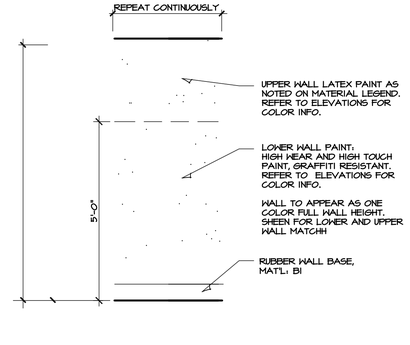

3 CHILDCARE
-
-

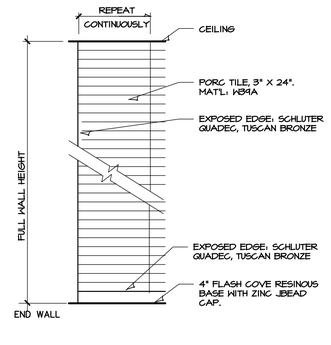

4 GYM MULTI-USER RESTROOM-
SUBSTRATE TO SUPPORT WEIGHT OF TILEWORK
REF TO DTL 11/A8.2 MAINTAIN CURRENT TCNA INSTALL. GUIDELINES

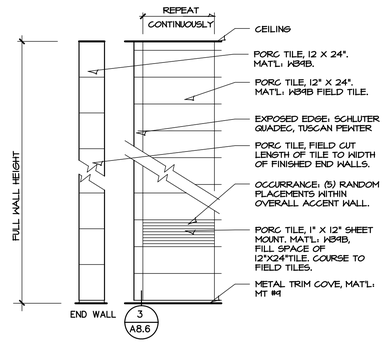

LOCKER ROOM LOUGE
SUBSTRATE TO SUPPORT WEIGHT OF TILEWORK
REF TO DTL 11/A8.2 MAINTAIN CURRENT TCNA INSTALL. GUIDELINES

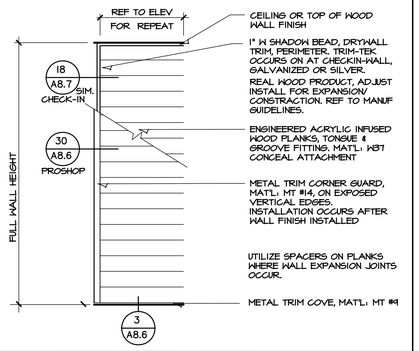

5 FEATURE WALL AT CHECK-IN & PROSHOP
REF TO ELEVATION FOR EXTENT OF FINISH
NEW PATTERN, CONFIRM W/ OWNER PRIOR TO ORDERING MAT'LS

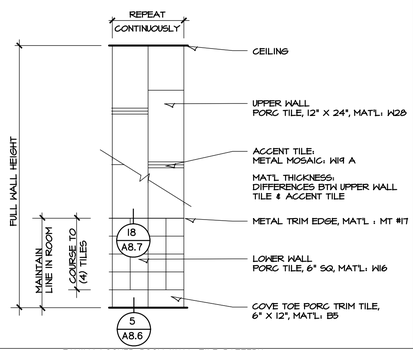

6 FAMILY LOCKER ROOM WALL TILE PATTERN
KERDI-DS WATERPROOF MEMBRANE, FULL COVERAGE
REF TO DTL 8/A8.0 MAINTAIN CURRENT TCNA INSTALL. GUIDELINES

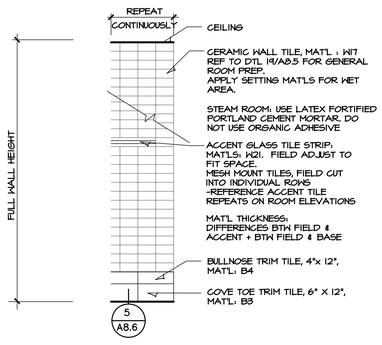

7 STEAM ROOM WALL PATTERN
KERDI-DS WATERPROOF MEMBRANE, FULL COVERAGE
REF TO DTL 8/A8.0 MAINTAIN CURRENT TCNA INSTALL. GUIDELINES

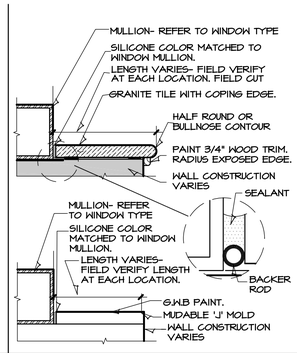

8 WINDOW SILL

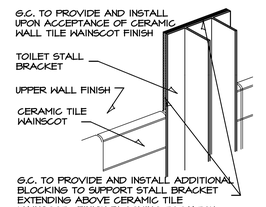

9 TILE AT TOILET PARTITION BRACKET

INSTALLATION DETAILS

DETAIL MOVED

10 DETAIL FOUND 10/A6.4
REFER TO SHEET A8.2 FOR TILE INSTALLATION INFO.

DETAIL MOVED

11 REFER TO DETAIL 7/A6.4
REFER TO SHEET A8.2 FOR TILE INSTALLATION INFO.

DETAIL MOVED

12 REFER TO DETAIL 8/A6.4
REFER TO SHEET A8.2 FOR TILE INSTALLATION INFO.

DETAIL MOVED

13 REFER TO DETAIL 9A/A6.4
REFER TO SHEET A8.2 FOR TILE INSTALLATION INFO.

DETAIL MOVED

14 REFER TO DETAIL 9B/A6.4
REFER TO SHEET A8.2 FOR TILE INSTALLATION INFO.

DETAIL MOVED

15 REFER TO DETAIL 11/A6.4
GLASS SHOWER DOOR DETAILS FOUND ON SHEET A6.3.

DETAIL MOVED

16 REFER TO DETAIL 5A/A6.4

DETAIL MOVED

17 REFER TO DETAIL 5B/A6.4

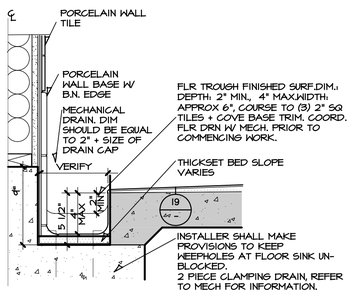

18 FLOOR TRENCH IN LOCKER SHOWER ROOM
REFER TO SHEET A8.2 FOR TILE INSTALLATION INFO.

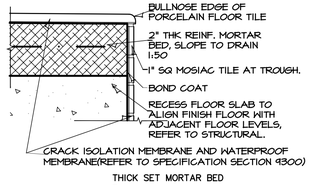

19 FLOOR TILE IN SHOWER ROOM
REFER TO SHEET A8.2 FOR TILE INSTALLATION INFO.

ARCHITECTS

KANSAS PROFESSIONAL ARCHITECT KEVIN ROY HANNEY 07107 IOWA

4/20/22

HANNEY & ASSOCIATES ARCHITECTS
1728 South Hillside, Wichita, Kansas, 67211
Phone (316) 683-8965
Fax (316) 684-1441

2022
GENESIS HEALTH CLUBS
SOUTHRIDGE MALL
1111 East Army Post Road
Des Moines, Iowa 50315

HEALTH GENESIS CLUBS

DRAWINGS ISSUED		
NO.	DATE	ITEM ISSUED
10	4/20/22	ADDENDUM #2
9	2/11/22	PERMIT SET
8	1/25/22	CHECK SET
7	12/15/21	CHECK SET
6	9/24/21	CHECK SET
5	8/27/21	SITE PLAN REVIEW
4	7/21/21	UDRB SUBMITTAL
3	7/08/21	MILESTONE DEV. PLAN
2	5/25/21	CONCEPT. DEV. PLAN
1	3/20/21	CONCEPT. DEV. PLAN

COMPUTER DRAWING
DMS_A805.dwg

DATE: AUGUST 2021	
DRAWN BY:	CHECKED BY:
MH, CH, DH, TH, TC	MRH

SHEET
A8.5
OF - SHEETS